

SURVEY & REMONUMENTATION

MAY 10 2000

RECEIVED

1999 DEC -3 PM 12: 43

SECTION

LAND CORNER RECORDATION CERTIFICATE
Filing Requirement of Act 74, Mich. P.A. 1970

Linda Longmiller
WEXFORD COUNTY, MI
REGISTERED DEEDS

For corners in

<u>WEXFORD</u> (County)	Located In:	Corner Code #
1. Public Land Survey	T <u>21N</u> R <u>9W</u>	<u>I-11</u>
	T _____ R _____	_____
	T _____ R _____	_____
	T _____ R _____	_____
2. Property Controlling in Section	S _____ T _____ R _____	_____
	S _____ T _____ R _____	_____
3. Miscellaneous Property in Sec.	S _____ T _____ R _____	_____
	S _____ T _____ R _____	_____
4. Lot No. _____, Recorded Plat _____		
5. Private Claims _____		

Register of Deeds Stamp & File Number

	A	B	C	D	E	F	G	H	I	J	K	L	M
1													
2	6		5		4			3		2			1
3													
4	7		6		9			10		11			12
5													
6	18		17		16			15		14			13
7													
8	19		20		21			22		23			24
9													
10	30		29		28			27		26			25
11													
12	31		32		33			34		35			36
13													

I, CRAIG J. PULLEN, PS, in a field survey on July 28, 1999, do hereby state that under requirements of P.A. 74, Michigan P.A. of 1970, the corner points mentioned in lines 1 and 2 above were in conformance with regulations and rules therefore as required in the current manual of survey instructions of the United States Department of the Interior, Bureau of Land Management or by a decree of a Court of Law and/or that the corner points mentioned in lines 3, 4 and 5 above were in conformance with the rules of the Michigan Board of Land Surveyors or by a Decree of a Court of Law; established, re-established, monumented, recovered, found as expressed below:

NOTE: Not more than 2 corners, all in the same town and range, may be recorded on this certificate.

A. Description of original monument and accessories and/or subsequent restoration:

- I-11 1848 G.L.O. RESURVEY BY O. LYON, WOOD POST, SUGAR TREE 11 S74W 8, SUGAR TREE 26 S37E 7
- 1880 A. J. TEED SURVEY IN SECTION 35, FOUND REMAINS OF BOTH WIT. AND STAKE, PUT IN IRON & STONE
- 1894 A. J. TEED SURVEY IN SECTION 35, GOOD STAKE AND STONE
- 1897 A. J. TEED SURVEY IN SECTION 27, NO WITNESSES
- 1901 D. E. TEED SURVEY IN SECTION 35, NO WITNESSES
- UNDATED OLD WITNESS BOOK 1" STEEL SHAFT, 10" APPLE S48°E 74.70', TP N40°W 60.50', TP N33°E 37.60'
- 1975 WILCOX & ASSOC. SURVEY IN SECTION 27 BY JERRY L. WILCOX PS#14102 L.1, P.340, FD. 1" STEEL SHAFT IN MON. BOX, S48°E 10" APPLE 74.70', N40°W T. P. 60.50', N33°E TP 37.60'
- 1977 JERRY L. WILCOX PS#14102 L.C.R.C. L.3, P.144, FD. IRON IN MON BOX, S45°E P. POLE 45.18', N40°E 6" R. PINE 82.00', S80°W YIELD SIGN POST 42.00'
- 1978 JACK F. ERICKSON PS#16929 SURVEY IN SECTION 34, L.1, P.686, L.C.R.C. L.3, P.197 FD. IRON IN MON BOX CL ROAD INTERSECTION. S40°W 7" PINE 92.00', S45°E P. POLE 45.25'
- 1993 FRANCIS E. FINNERTY PS#16038 SURVEY IN SECTION 35, NO WITNESSES
- 1997 WADE-TRIM SURVEY IN SECTION 34 BY CRAIG J. PULLEN PS#39095, L.77, P.398, FOUND 1/2" IRON IN MON BOX, N30°E P. POLE 108.92', N50°E 10" R. PINE 84.64', S40°E P. POLE 45.19', S80°W P. POLE 109.25'

B. Description of corner evidence found and/or method applied in restoring or reestablishing corner:


- I-11 FOUND 5/8" IRON IN MONUMENT BOX, IN CENTERLINE 45 ROAD; ALSO FOUND ONE 1997 WITNESS AND TWO 1978 WITNESSES. ADDED BRASS CAP. THIS CORNER IS ACCEPTED AS THE BEST AVAILABLE EVIDENCE OF THE POSITION OF THE CORNER.

C. Description of monument for corner and accessories established to perpetuate locating the position of the corner:

- I-11 SECTION CORNER COMMON TO SECTIONS 26, 27, 34 & 35, T21N, R9W
5/8" IRON & BRASS CAP STAMPED 26,27,34,35 #39095, 1999, CJP
N19°E POWER POLE 108.94'
S40°E POWER POLE 45.19'
S87°W POWER POLE 109.26'
S38°W 13" RED PINE 92.00'

Peer Group Reviewed and Approved

Date: 12 Nov 99
Richard D. Wilcox
Richard D. Wilcox, Wexford County Surveyor

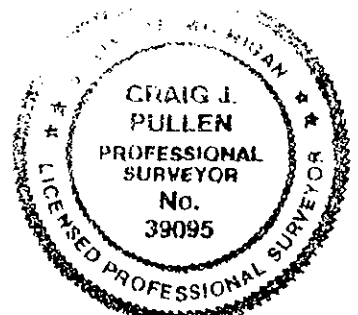

Signed by *Craig J. Pullen*

Date November 5, 1999

Surveyor's Michigan License No. 39095

FORM APPROVED BY MICHIGAN STATE BOARD OF PROFESSIONAL SURVEYORS, JAN. 28, 1971

REVISED MAY 14, 1975
REVISED JAN., 1983
REVISED OCT., 1995