

**SURVEY &
REMONUMENTATION**

MAY 10 2000

LAND CORNER RECORDATION CERTIFICATE
Filing Requirement of Act 74, Mich. P.A. 1970

RECEIVED

1999 DEC -3 PH 12: 44

SECTION

For corners in

Linda Laughmiller
WEXFORD COUNTY, MI
REGISTERED DEEDS

<u>WEXFORD</u> (County)	Located In:	Corner Code #
1. Public Land Survey	T <u>21N</u> R <u>9W</u>	<u>I-12</u>
	T _____ R _____	_____
	T _____ R _____	_____
	T _____ R _____	_____
2. Property Controlling in Section	S _____ T _____ R _____	_____
	S _____ T _____ R _____	_____
3. Miscellaneous Property in Sec.	S _____ T _____ R _____	_____
	S _____ T _____ R _____	_____
4. Lot No. _____, Recorded Plat _____		
5. Private Claims _____		

Register of Deeds Stamp & File Number

	A	B	C	D	E	F	G	H	I	J	K	L	M
1													
2		6		5		4		3		2		1	
3													
4		7		8		9		10		11		12	
5													
6		18		17		16		15		14		13	
7													
8		19		20		21		22		23		24	
9													
10		30		29		28		27		26		25	
11													
12		31		32		33		34		35		36	
13													

I, CRAIG J. PULLEN, PS, in a field survey on July 28 & October 25, 1999, do hereby state that under requirements of P.A. 74, Michigan P.A. of 1970, the corner points mentioned in lines 1 and 2 above were in conformance with regulations and rules therefore as required in the current manual of survey instructions of the United States Department of the Interior, Bureau of Land Management or by a decree of a Court of Law and/or that the corner points mentioned in lines 3, 4 and 5 above were in conformance with the rules of the Michigan Board of Land Surveyors or by a Decree of a Court of Law; established, re-established, monumented, recovered, found as expressed below:

NOTE: Not more than 2 corners, all in the same town and range, may be recorded on this certificate.

A. Description of original monument and accessories and/or subsequent restoration:

- I-12 1848 G.L.O. RESURVEY BY O. LYON, WOOD POST, HEMLOCK 20 S35W 16, SUGAR TREE 28 N143/4E 23
- 1880 A. J. TEED SURVEY IN SECTION 35, FD. STAKE AND BOTH WIT. ELM 36 N12 1/2 W 70L
- 1894 A. J. TEED SURVEY IN SECTION 35, NO WITNESSES
- 1901 D. E. TEED SURVEY IN SECTION 35, NO DESC. OF CORNER, ELM 5 N75W 57 1/2, ELM 5 N81W 87 1/2
- 1978 JACK F. ERICKSON PS#16929, L.C.R.C. L.3, P.197, SET 1/2" IRON ON STRAIGHT LINE & PROPORTIONAL DISTANCE N80°W 12" MAPLE 19.70', S35°E 18" TWIN MAPLE 29.80'
- 1996 DANIEL E. SCHRIPSEMA PS#24617 SURVEY IN SECTION 35, SET 1/2" IRON & CAP 4.5' EAST OF FENCE COR., RESET BY 1901 WIT. N81°W 30" DEAD ELM 57.75', N75°W 28" ELM ROOTS 37.95', N70°W 22.10' 30" MAPLE, S70°W 39.36' 12" R. PINE, N10°W 24.10' 8" CHERRY, S35°E 54.76' 18" APPLE
- 1997 WADE-TRIM SURVEY IN SECTION 34 BY CRAIG J. PULLEN PS#39095, L.77, P.398, FOUND IRON & CAP SET BY SCHRIPSEMA, N80°W 20" MAPLE 22.15', S40°W 10" R. PINE 47.15', N40°W 8" CHERRY 34.30', N20°W 7" CHERRY 24.12'

B. Description of corner evidence found and/or method applied in restoring or reestablishing corner:

- I-12 FOUND 1/2" X 18" IRON #24617, 1901 WITNESSES (STUMPS), AND ALL FOUR 1997 WITNESSES. REPLACED WITH 5/8" X 36" IRON AND BRASS CAP. CORNER IS 3.5' EAST OF OLD DOWN FENCE. REMOVED 1/2" IRON SET BY ERICKSON 3.50' NW. OLD FENCE RUNNING WEST IS 1' SOUTH. THIS CORNER IS ACCEPTED AS A CAREFUL AND FAITHFUL PERPETUATION OF THE POSITION OF THE ORIGINAL CORNER.


C. Description of monument for corner and accessories established to perpetuate locating the position of the corner:

- I-12 1/4 CORNER COMMON TO SECTIONS 34 & 35, T21N, R9W
- 5/8" X 36" IRON & BRASS CAP STAMPED: 34, 35, 1/4 COR, #39095, 1999, CJP
- N80°W 20" MAPLE 22.15'
- N40°W 8" CHERRY 34.30'
- N20°W 7" CHERRY 24.12'
- S40°W 10" RED PINE 47.13'

Peer Group Reviewed and Approved

Date: 12 Nov 99

Richard D. Wilcox
Richard D. Wilcox, Wexford County Surveyor

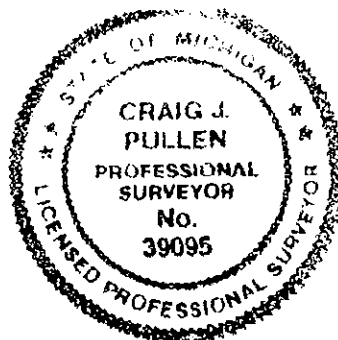

Signed by Craig J. Pullen

Date November 5, 1999

Surveyor's Michigan License No. 39095