

**SURVEY & REMONUMENTATION**

MAY 10 2000

**SECTION**

**LAND CORNER RECORDATION CERTIFICATE**  
Filing Requirement of Act 74, Mich. P.A. 1970

RECEIVED

1999 DEC -3 PM 12:44

*Linda Longmiller*  
WEXFORD COUNTY, MI  
REGISTER OF DEEDS

For corners in

<u>WEXFORD</u> (County)	Located In:	Corner Code #
1. Public Land Survey	T <u>21N</u> R <u>9W</u>	<u>J-11</u>
	T _____ R _____	_____
	T _____ R _____	_____
	T _____ R _____	_____
2. Property Controlling in Section	S _____ T _____ R _____	_____
	S _____ T _____ R _____	_____
3. Miscellaneous Property in Sec.	S _____ T _____ R _____	_____
	S _____ T _____ R _____	_____
4. Lot No. _____, Recorded Plat _____		
5. Private Claims _____		

Register of Deeds Stamp & File Number

	A	B	C	D	E	F	G	H	I	J	K	L	M
1													
2	6		5		4		3		2		1		
3													
4	7		8		9		10		11		12		
5													
6	18		17		16		15		14		13		
7													
8	19		20		21		22		23		24		
9													
10	30		29		28		27		26		25		
11													
12	31		32		33		34		35		36		
13													

I, CRAIG J. PULLEN, PS, in a field survey on JUNE 18, 1999, do hereby state that under requirements of P.A. 74, Michigan P.A. of 1970, the corner points mentioned in lines 1 and 2 above were in conformance with regulations and rules therefore as required in the current manual of survey instructions of the United States Department of the Interior, Bureau of Land Management or by a decree of a Court of Law and/or that the corner points mentioned in lines 3, 4 and 5 above were in conformance with the rules of the Michigan Board of Land Surveyors or by a Decree of a Court of Law; established, re-established, monumented, recovered, found as expressed below:

**NOTE: Not more than 2 corners, all in the same town and range, may be recorded on this certificate.**

**A. Description of original monument and accessories and/or subsequent restoration:**

- J-11 1848 G.L.O. RESURVEY BY O. LYON, WOOD POST, WHITE ASH 8 S60½W 24 SUGAR TREE 14 N50E 42
- 1880 A. J. TEED SURVEY IN SECTION 35, FOUND W. ASH & RESET COR.
- 1894 A. J. TEED SURVEY IN SECTION 35 NO WITNESSES OR CORNER DESCRIPTION
- 1901 D. E. TEED SURVEY IN SECTION 35 NO WITNESSES OR CORNER DESCRIPTION. DISTANCE TO NW CORNER 2632.08'
- 1903 D. E. TEED SURVEY IN SECTION 26 RESET FROM SUGAR WIT. NW, STAKES 2 RODS N & S, DISTANCE TO SE COR. 2640'
- 1977 JERRY L. WILCOX PS#14102 L.C.R.C. L.3, P.144 SET WEX. CO. MON BY S. P., SOUTH COR. FE. POST 23.69' S50°E 5" R. PINE 51.11', N15°E 3" MAPLE 23.20', N45°W 48" MAPLE 45.34'
- 1993 FRANCIS E. FINNERTY PS#16038 SURVEY IN SECTION 35, NO WITNESSES OR CORNER DESCRIPTION. DISTANCE TO NW COR. 2641.90'
- 1996 DANIEL E. SCHRIPSEMA PS#24617 UNRECORDED SURVEY IN SECTION 35, CORNER NOTED AS RECORDED IN L.C.R.C. L.3, P.144
- 1996 WADE-TRIM SURVEY IN SECTION 35, FOUND CO. MON. N40°W 28" MAPLE 45.44', S40°E 12" R. PINE 44.22', S5°W 10" APPLE 28.41', N25°E 6" MAPLE 23.19'

**B. Description of corner evidence found and/or method applied in restoring or reestablishing corner:**


J-11 FOUND OLD WEXFORD COUNTY MONUMENT 1' NORTH OF CENTERLINE 50 ROAD AND TWO 1971 WITNESSES. REPLACED WITH 5/8"X36" IRON WITH BRASS CAP. THIS CORNER IS ACCEPTED AS THE BEST AVAILABLE EVIDENCE OF THE POSITION OF THE ORIGINAL CORNER.

**C. Description of monument for corner and accessories established to perpetuate locating the position of the corner:**

- J-11 1/4 CORNER COMMON TO SECTIONS 26 & 35, T21N, R9W
- 5/8"X36" IRON & BRASS CAP STAMPED: 1999, CJP, 39095, 26, 35, ¼
- N25°E 8" MAPLE 23.19'
- S27°E 10" RED PINE 44.16'
- S10°W 9" APPLE 28.31'
- N40°W 50" MAPLE 45.46'

Peer Group Reviewed and Approved

Date: 12 Nov 99  
*Richard D. Wilcox*  
Richard D. Wilcox, Wexford County Surveyor

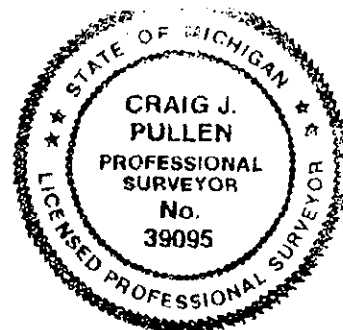

Signed by *Craig J. Pullen*

Date November 3, 1999

Surveyor's Michigan License No. 39095