

SURVEY & REMONUMENTATION

MAY 10 2000

SECTION

LAND CORNER RECORDATION CERTIFICATE
Filing Requirement of Act 74, Mich. P.A. 1970

For corners in

<u>WEXFORD COUNTY</u>	Located In:	Corner Code #
1. Public Land Survey	<u>T 21N R 09W</u>	<u>K-2</u>
	T _____ R _____	_____
	T _____ R _____	_____
	T _____ R _____	_____
2. Property Controlling in Section	S _____ T _____ R _____	_____
	S _____ T _____ R _____	_____
3. Miscellaneous Property in Sec.	S _____ T _____ R _____	_____
	S _____ T _____ R _____	_____

RECEIVED
 1999 DEC -1 PM 3: 06
Richard D. Wilcox
 WEXFORD COUNTY MI
 REGISTERED SURVEYORS

Register of Deeds Stamp & File Number

4. Lot No. _____, Recorded Plat _____

5. Private Claims _____

	A	B	C	D	E	F	G	H	I	J	K	L	M
1													
2		6		5		4		3		2	●	1	
3													
4		7		8		9		10		11		12	
5													
6		18		17		16		15		14		13	
7													
8		19		20		21		22		23		24	
9													
10		30		29		28		27		26		25	
11													
12		31		32		33		34		35		36	
13													

I, George D. Smith, P.S., in a field survey on June, 19 99 do hereby state that under requirements of P.A. 74, Michigan P.A. of 1970, the corner points mentioned in lines 1 and 2 above were in conformance with regulations and rules therefore as required in the current manual of survey instructions of the United States Department of the Interior, Bureau of Land Management or by a decree of a Court of Law and for that the corner points mentioned in lines 3, 4 and 5 above were in conformance with the rules of the Michigan Board of Land Surveyors or by a Decree of a Court of Law; established, re-established, monumented, recovered, found as expressed below:

NOTE: Not more than 2 corners, all in the same town and range, may be recorded on this certificate.

A. Description of original monument and accessories and/or subsequent restoration:

- K-2) 1848 GLO subdivision by Orson Lyon, D.S. 12" Beech-N51E-32, Beech-5 1/2 W-28.
- 1974 J.L. Wilcox, PS #14102, Certificate of Survey, Liber 1, Page 186. Found 1 1/2" pipe ± 5' west of fence north-south and 7' south of fence east, 15' east of centerline of pipeline, N80W-51.68'-8" white pine, S40W-44.07'-12" Beech, N75E-45.88'-18" Oak.
- 1974 J.L. Wilcox, PS #14102, Plat of Pointe East, Liber 1, Page 7 of Plats, found 1 1/2" pipe.
- 1977 Nelson, PS #21273, LCRC Liber 3, Page 163. Found 2" pipe 5' west and 7' south of fence corner and 15' east of center of pipeline, 20" Oak-AZ.73°-45.92', 18" twin beech-AZ.117-68.57', 12" maple-AZ.227-44.07', 8" white pine-AZ.293-51.64'.
- 1977 Nelson, PS #21273, Certificate of Survey, Liber 1, Page 576. Found 1 1/2" pipe.
- 1990 G. Carlson, PS #24589, LCRC Liber 4, Page 71. Found 1 1/2" diameter pipe. 13" double maple-S49W-44.14', 13" white pine-N63W-51.66', 8" double maple-N76E-25.62', 10" double maple-S59E-30.42'.


B. Description of corner evidence found and/or method applied in restoring or reestablishing corner:

- K-2) Found 1 1/2" pipe and two witnesses from 1974 Wilcox LCRC, three witnesses from 1990 Carlson LCRC, and one witness from 1977 Nelson LCRC. This corner is accepted as the best available evidence of the position of the original corner being the quarter section corner common to Sections 1 and 2, T21N, R9W.

C. Description of monument for corner and accessories established to perpetuate locating the position of the corner:

- K-2) Set 5/8"x36" iron with Wexford County brass cap stamped 2, 1 1999, PS #39098 in center of pipe.

S47W	40.09	16" Twin Maple
S58E	30.35	10" Twin Maple (1990 Carlson 30.42)
N79E	25.61	10" Twin Maple (1990 Carlson 25.62)
N67W	51.56	14" W. Pine (1990 Carlson 51.66, 1977 Nelson 51.64, 1974 Wilcox 51.68)

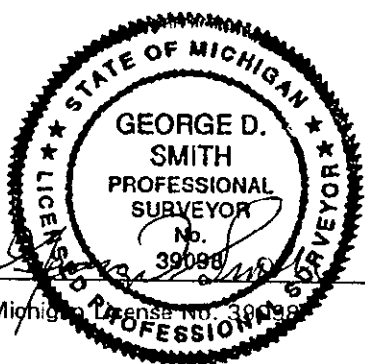

LIBER 05 PAGE 161

Peer Group Reviewed and Approved
 Date: 12 Nov 99
Richard D. Wilcox
 Richard D. Wilcox, Wexford County Surveyor

Signed by _____
 Surveyor's Michigan License No. 39098

Date 11-12-99