

SURVEY & REMONUMENTATION

MAY 10 2000

SECTION

LAND CORNER RECORDATION CERTIFICATE
 Filing Requirement of Act 74, Mich. P.A. 1970

RECEIVED

1999 DEC -1 PM 3:05

Linda Loughmiller
 WEXFORD COUNTY, MI
 REGISTER OF DEEDS

For corners in

<u>WEXFORD COUNTY</u>	Located In:	Corner Code #
1. Public Land Survey	T <u>21N</u> R <u>09W</u>	<u>K-5</u>
	T _____ R _____	_____
	T _____ R _____	_____
	T _____ R _____	_____
2. Property Controlling in Section	S _____ T _____ R _____	_____
	S _____ T _____ R _____	_____
3. Miscellaneous Property in Sec.	S _____ T _____ R _____	_____
	S _____ T _____ R _____	_____

Register of Deeds Stamp & File Number

4. Lot No. _____, Recorded Plat _____

5. Private Claims _____

I, George D. Smith, P.S., in a field survey on June, 19 99 do hereby state that under requirements of P.A. 74, Michigan P.A. of 1970, the corner points mentioned in lines 1 and 2 above were in conformance with regulations and rules therefore as required in the current manual of survey instructions of the United States Department of the Interior, Bureau of Land Management or by a decree of a Court of Law and /or that the corner points mentioned in lines 3, 4 and 5 above were in conformance with the rules of the Michigan Board of Land Surveyors or by a Decree of a Court of Law; established, re-established, monumented, recovered, found as expressed below:

	A	B	C	D	E	F	G	H	I	J	K	L	M
1													
2		6		5		4		3		2		1	
3													
4		7		8		9		10		11		12	
5													
6		18		17		16		15		14		13	
7													
8		19		20		21		22		23		24	
9													
10		30		29		28		27		26		25	
11													
12		31		32		33		34		35		36	
13													

NOTE: Not more than 2 corners, all in the same town and range, may be recorded on this certificate.

A. Description of original monument and accessories and/or subsequent restoration:

- K-5) 1848 GLO subdivision by Orson Lyon D.S. 22" Hemlock-S75E-15, 8" Hemlock-N85 1/2 W-16.
- 1883 Bradly Survey Liber 1, Page 20, corner found no witnesses or description given.
- 1955 Supervisors plat of Fisk's Berry Lake Liber 4, Page 125 of Plats by Frank McClung, corner used, no description or witnesses given.
- 1967 Sunset View Plat of Berry Lake by J. Switalski, PS #13045 recorded in Liber 5, Pages 188-189 of Plats corner used no description or witnesses given.

A continued on back


B. Description of corner evidence found and/or method applied in restoring or reestablishing corner:

- K-5) Found Wexford County Monument and three witnesses from 1977 Erickson PS 16929 LCRC. This corner is accepted as the best available evidence of the position of the original corner being the section corner common to Sections 11, 12, 14, 13, T21N, R9W.

C. Description of monument for corner and accessories established to perpetuate locating the position of the corner:

- K-5) Wexford County Monument

N56W	43.74	Powerpole (1977 Erickson 43.56)
N62W	73.69	8" Maple clump
N07E	61.77	Southwest corner garage concrete footing (1977 Erickson 61.60)
N34E	72.32	Southeast corner garage concrete footing (1977 Erickson 72.29)

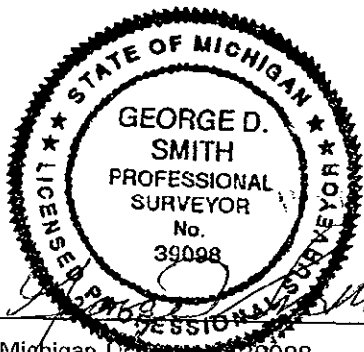

LIBER 05 PAGE 179

Peer Group Reviewed and Approved

Date: 12 Nov 99
Richard D. Wilcox
 Richard D. Wilcox, Wexford County Surveyor

Signed by _____
 Surveyor's Michigan License No. 39098

Date 11-12-99