

**SURVEY &
REMONUMENTATION**

MAY 10 2000

SECTION

LAND CORNER RECORDATION CERTIFICATE
Filing Requirement of Act 74, Mich. P.A. 1970

For corners in

WEXFORD
(County)

Located In:

Corner Code #

- | | | |
|---------------------------------------|----------------------------|------------|
| 1. Public Land Survey | T <u>21</u> N R <u>9</u> W | <u>K-6</u> |
| | T _____ R _____ | _____ |
| | T _____ R _____ | _____ |
| | T _____ R _____ | _____ |
| 2. Property Controlling in Section | S _____ T _____ R _____ | _____ |
| | S _____ T _____ R _____ | _____ |
| 3. Miscellaneous Property in Sec. | S _____ T _____ R _____ | _____ |
| | S _____ T _____ R _____ | _____ |
| 4. Lot No. _____, Recorded Plat _____ | | |
| 5. Private Claims _____ | | |

RECEIVED
1999 DEC -3 PM 12: 44
Linda Loughmiller
WEXFORD COUNTY, MI
REGISTER OF DEEDS

Register of Deeds Stamp & File Number

	A	B	C	D	E	F	G	H	I	J	K	L	M
1													
2	6			5		4		3		2		1	
3													
4	7			8		9		10		11		12	
5													
6	18			17		16		15		14		13	
7													
8	19			20		21		22		23		24	
9													
10	30			29		28		27		26		25	
11													
12	31			32		33		34		35		36	
13													

I, CRAIG J. PULLEN, PS, in a field survey on AUGUST 13, 1999, do hereby state that under requirements of P.A. 74, Michigan P.A. of 1970, the corner points mentioned in lines 1 and 2 above were in conformance with regulations and rules therefore as required in the current manual of survey instructions of the United States Department of the Interior, Bureau of Land Management or by a decree of a Court of Law and/or that the corner points mentioned in lines 3, 4 and 5 above were in conformance with the rules of the Michigan Board of Land Surveyors or by a Decree of a Court of Law; established, re-established, monumented, recovered, found as expressed below:

NOTE: Not more than 2 corners, all in the same town and range, may be recorded on this certificate.

A. Description of original monument and accessories and/or subsequent restoration:


- K-6 1848 G.L.O. RESURVEY BY O. LYON, WOOD POST, BEECH 8 S56½W 17, HEMLOCK 6 N49E 10
- 1888 FULLER SURVEY IN SECTION 14 NO WITNESSES
- 1889 A. J. TEED SURVEY IN SECTION 13 FOUND STAKE AND STONE
- UNDATED COUNTY WITNESS BOOK MONUMENT BOX NO WITNESSES
- 1976 JACK F. ERICKSON PS#16929 L.C.R.C. RECORDED L.2, P.791. FOUND T-IRON IN MONUMENT BOX IN ROAD INTERSECTION. NO WITNESSES.
- 1994 MITCHELL & ASSOCIATES SURVEY BY DONALD A. GRIER PS#33978 IN SECTION 14, T21N, R9W, L.77, P.286 FOUND T-IRON IN MONUMENT BOX IN INTERSECTION
- 1997 GEORGE SMITH PS#39098 L.C.R.C. L.5, P.15 FOUND ANGLE IRON IN MONUMENT BOX AS RECORDED L.2, P.791 N44°W 67.67' 14" RED PINE FOUND NAIL, N75°E 77.85' 24" COTTONWOOD FOUND NAIL, S50°E 56.27' POWER POLE FOUND NAIL, N34°W 81.90' 14" RED PINE SET NAIL

B. Description of corner evidence found and/or method applied in restoring or reestablishing corner:

- K-6 FOUND T- IRON IN MON BOX 1' SOUTH OF CENTERLINE OF 44½ ROAD IN CENTERLINE OF 47 ROAD. SET 5/8"X36" IRON AND BRASS CAP. THIS CORNER IS ACCEPTED AS THE BEST AVAILABLE EVIDENCE OF THE POSITION OF THE CORNER.

C. Description of monument for corner and accessories established to perpetuate locating the position of the corner:

- K-6 1/4 CORNER COMMON TO SECTIONS 13 &14, T21N, R9W
- 5/8"X36" IRON & BRASS CAP STAMPED: CJP, 1999, 39095, ¼, 13, 14
- N70°E 30" COTTONWOOD 77.83'
- S54°E POWER POLE 56.28'
- N47°W 14" RED PINE 67.63'
- N30°W 14" RED PINE 81.89'

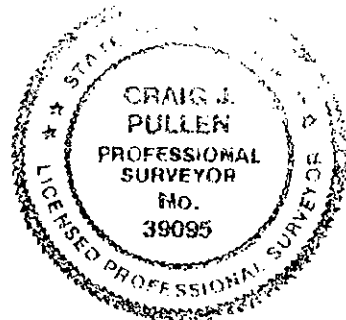

Peer Group Reviewed and Approved

Date: 12 Nov 99
Richard D. Wilcox
Richard D. Wilcox, Wexford County Surveyor

Signed by Craig J. Pullen

Date October 21, 1999

Surveyor's Michigan License No. 39095

FORM APPROVED BY MICHIGAN STATE BOARD OF PROFESSIONAL SURVEYORS, JAN. 28, 1971

REVISED MAY 14, 1975
REVISED JAN., 1983
REVISED OCT., 1995