

SURVEY & REMONUMENTATION

MAY 10 2000

RECEIVED

1999 DEC -3 PM 12: 44

SECTION

**LAND CORNER RECORDATION CERTIFICATE
Filing Requirement of Act 74, Mich. P.A. 1970**

Linda Loughmiller
WEXFORD COUNTY, MI
REGISTERED DEEDS

For corners in

<u>WEXFORD</u> (County)	Located In:	Corner Code #
1. Public Land Survey	T <u>21N</u> R <u>9W</u>	<u>K-7</u>
	T _____ R _____	_____
	T _____ R _____	_____
	T _____ R _____	_____
2. Property Controlling in Section	S _____ T _____ R _____	_____
	S _____ T _____ R _____	_____
3. Miscellaneous Property in Sec.	S _____ T _____ R _____	_____
	S _____ T _____ R _____	_____
4. Lot No. _____, Recorded Plat _____		
5. Private Claims _____		

Register of Deeds Stamp & File Number

	A	B	C	D	E	F	G	H	I	J	K	L	M
1													
2		6		5		4		3		2		1	
3													
4		7		8		9		10		11		12	
5													
6		18		17		16		15		14		13	
7													
8		19		20		21		22		23		24	
9													
10		30		29		28		27		26		25	
11													
12		31		32		33		34		35		36	
13													

I, CRAIG J. PULLEN, PS, in a field survey on JULY 19, 1999, do hereby state that under requirements of P.A. 74, Michigan P.A. of 1970, the corner points mentioned in lines 1 and 2 above were in conformance with regulations and rules therefore as required in the current manual of survey instructions of the United States Department of the Interior, Bureau of Land Management or by a decree of a Court of Law and/or that the corner points mentioned in lines 3, 4 and 5 above were in conformance with the rules of the Michigan Board of Land Surveyors or by a Decree of a Court of Law; established, re-established, monumented, recovered, found as expressed below:

NOTE: Not more than 2 corners, all in the same town and range, may be recorded on this certificate.

A. Description of original monument and accessories and/or subsequent restoration:

- K-7 1848 G.L.O. RESURVEY BY O. LYON, WOOD POST, HEMLOCK 11 S37E 15, HEMLOCK 21 N26W 22
- 1883 A. J. TEED SURVEY IN SECTION 23 GOOD STAKE AND BOTH WITNESSES
- 1965 COUNTY ROAD COMMISSION WITNESS BOOK STEEL FENCE POST, 8" APPLE S70°W 131.53', ROAD SIGN S45°E 50.64' CORNER FENCE POST N45°E 44.68', TELEPHONE PEDESTAL N45°W 38.00'
- 1976 JACK F. ERICKSON PS#16929 SURVEY IN SECTION 13, L.1, P.379 L.C.R.C. RECORDED L.2, P.791, FOUND IRON IN BIT, N45°E FENCE CORNER 45.00', N70°W POWER POLE 141.20'
- 1978 MATTHEW M. MCCLUNG PS#13037 L.C.R.C. L.3, P.316, FOUND S IRON IN BLACKTOP, N. END CEMENT CULVERT N45°E 34.75', S. END CEMENT CULVERT S55°E 30.5'
- 1993 WADE-TRIM SURVEY BY JAMES A. RAY PS#25869, L.75, P.364, FOUND 1" X 1" ANGLE IRON, N65°W POWER POLE 141.25', N77°E POWER POLE 167.72', S60E POWER POLE 172.78' S50°W ROAD SIGN 53.4'
- 1997 GEORGE SMITH PS#39098 L.C.R.C. L.5, P.15 FOUND ANGLE IRON IN MONUMENT BOX AS RECORDED IN L.2, P.791 & L.3, P.316, N60°W 48.88' SET IRON, S74°W 53.69' SET IRON, S58°E 44.60' SET IRON, N58°E 39.69' SET IRON


B. Description of corner evidence found and/or method applied in restoring or reestablishing corner:

- K-7 FOUND 1 1/2" ANGLE IRON IN MONUMENT BOX 4' EAST OF CENTERLINE OF 47 ROAD 2' SOUTH OF CENTERLINE OF 46 ROAD. SET 5/8"X36" IRON AND BRASS CAP. THIS CORNER IS ACCEPTED AS THE BEST AVAILABLE EVIDENCE OF THE POSITION OF THE CORNER.

C. Description of monument for corner and accessories established to perpetuate locating the position of the corner:

- K-7 SECTION CORNER COMMON TO SECTIONS 13,14,23 & 24, T21N, R9W
- 5/8"X36" IRON & BRASS CAP STAMPED 13, 14, 23, 24, 39095, 1999
- N87°E POWER POLE 167.70'
- S68°E POWER POLE 172.75'
- N70°w POWER POLE 141.26'
- N19°W 16" WILLOW 124.26'

Peer Group Reviewed and Approved
Date: 12 Nov 99
Richard D. Wilcox
Richard D. Wilcox, Wexford County Surveyor

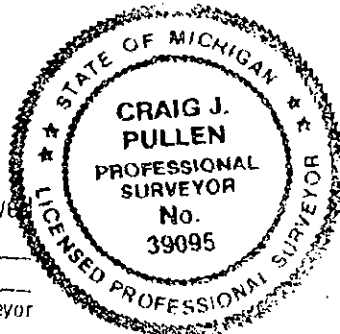

Signed by Craig J. Pullen Date October 21, 1999

Surveyor's Michigan License No. 39095 FORM APPROVED BY MICHIGAN STATE BOARD OF PROFESSIONAL SURVEYORS. JAN. 28, 1971