

MAY 10 2000

SECTION

LAND CORNER RECORDATION CERTIFICATE
Filling Requirement of Act 74, Mich. P.A. 1970

RECEIVED

1999 DEC -3 PM 12: 44

Linda Loughmiller
WEXFORD COUNTY, MI
REGISTER OF DEEDS

For corners in

Form with fields for WEXFORD (County), Located In: T 21N R 9W, Corner Code # K-11, and numbered sections 1-5 for survey types.

Register of Deeds Stamp & File Number

Grid table with columns A-M and rows 1-13, containing numerical data points.

I, CRAIG J. PULLEN, PS, in a field survey on AUGUST 13, 1999, do hereby state that under requirements of P.A. 74, Michigan P.A. of 1970, the corner points mentioned in lines 1 and 2 above were in conformance with regulations and rules therefore as required in the current manual of survey instructions of the United States Department of the Interior, Bureau of Land Management or by a decree of a Court of Law and/or that the corner points mentioned in lines 3, 4 and 5 above were in conformance with the rules of the Michigan Board of Land Surveyors or by a Decree of a Court of Law; established, re-established, monumented, recovered, found as expressed below:

NOTE: Not more than 2 corners, all in the same town and range, may be recorded on this certificate.

A. Description of original monument and accessories and/or subsequent restoration:

- List of survey records including G.L.O. RESURVEY BY O. LYON, DEVOE (PER TEED) SURVEY IN SECTION 35, A. J. TEED SURVEY IN SECTION 35, A. J. TEED SURVEY IN SECTION 25, D. E. TEED SURVEY IN SECTION 36, D. E. TEED SURVEY IN SECTION 26, JERRY L. WILCOX PS#14102 L.C.R.C. L.3, P.144, GRANGER ENGINEERING SURVEY BY JAMES A. RAY PS#25869, DANIEL E. SCHRIPEMA PS#24617 SURVEY IN SECTION 35.

B. Description of corner evidence found and/or method applied in restoring or reestablishing corner:

K-11 FOUND 1/2" X 18" IRON & CAP #21996 (FRED THOMSON) 1.5' EAST OF CENTERLINE 47 ROAD & 2' SOUTH OF CENTERLINE 50 ROAD REPLACED WITH 5/8"X36" IRON AND BRASS CAP. THIS CORNER IS ACCEPTED AS THE BEST AVAILABLE EVIDENCE OF THE POSITION OF THE CORNER.


C. Description of monument for corner and accessories established to perpetuate locating the position of the corner:

- K-11 SECTION CORNER COMMON TO SECTIONS 25, 26, 35 & 36 T21N, R9W
5/8"X36" IRON & BRASS CAP IN MONUMENT BOX STAMPED: CJP, 39095, 1999, 25, 26, 35 & 36
S20°E POWER POLE 96.09'
S76°W 36" CHERRY 103.33'
N45°W GUARD POST AT TELEPHONE PEDESTAL 43.70'
N21°W 14" RED PINE 97.79'

Peer Group Reviewed and Approved

Date: 12 Nov 99

Richard D. Wilcox, Wexford County Surveyor

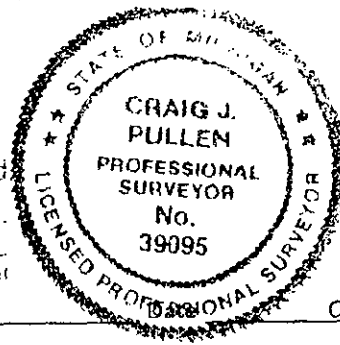

Signed by [Signature]

October 21, 1999

Surveyor's Michigan License No. 39095

FORM APPROVED BY MICHIGAN STATE BOARD OF PROFESSIONAL SURVEYORS, JAN. 28, 1971

REVISED MAY 14, 1975
REVISED JAN., 1983
REVISED OCT., 1995