

**SURVEY & REMONUMENTATION**

**MAY 10 2000**

**SECTION**

**LAND CORNER RECORDATION CERTIFICATE**  
Filing Requirement of Act 74, Mich. P.A. 1970

For corners in

<u>WEXFORD</u> (County)	Located In:	Corner Code #
1. Public Land Survey	T <u>21N</u> R <u>9W</u>	<u>L-9</u>
	T _____ R _____	_____
	T _____ R _____	_____
	T _____ R _____	_____
2. Property Controlling in Section	S _____ T _____ R _____	_____
	S _____ T _____ R _____	_____
3. Miscellaneous Property in Sec.	S _____ T _____ R _____	_____
	S _____ T _____ R _____	_____
4. Lot No. _____, Recorded Plat _____		
5. Private Claims _____		

RECEIVED  
1999 DEC -3 PM 12: 44  
*Linda Loughmiller*  
WEXFORD COUNTY, MI  
REGISTER OF DEEDS

Register of Deeds Stamp & File Number

I, CRAIG J. PULLEN, PS, in a field survey on AUGUST 13, 1999, do hereby state that under requirements of P.A. 74, Michigan P.A. of 1970, the corner points mentioned in lines 1 and 2 above were in conformance with regulations and rules therefore as required in the current manual of survey instructions of the United States Department of the Interior, Bureau of Land Management or by a decree of a Court of Law and/or that the corner points mentioned in lines 3, 4 and 5 above were in conformance with the rules of the Michigan Board of Land Surveyors or by a Decree of a Court of Law; established, re-established, monumented, recovered, found as expressed below:

NOTE: Not more than 2 corners, all in the same town and range, may be recorded on this certificate.

1	A	B	C	D	E	F	G	H	I	J	K	L	M
2		6		5		4		3		2		1	
3													
4		7		8		9		10		11		12	
5													
6		18		17		16		15		14		13	
7													
8		19		20		21		22		23		24	
9													
10		30		29		28		27		26		25	
11													
12		31		32		33		34		35		36	
13													

A. Description of original monument and accessories and/or subsequent restoration:


- L-9 1848 G.L.O. RESURVEY BY O. LYON, WOOD POST, SUGAR 9 S84W 8, BEECH 11 N48E 25
- 1898 A. J. TEED SURVEY IN SEC.25 SUGAR 20 S201/2W 105
- UNDATED OLD CO. WITNESS BOOK 2" IRON PIPE 8" ELM N60E 58.00, 5" MAPLE SOUTH 62.11, 20" MAPLE N50W 55.35
- 1981 JOHN A. MILLETICS PS#25859 SURVEY IN SEC.25, L.1, P.874 SET 1/2" IRON OVER PLOW POINT SOUTH 62.15' 20" MAPLE, S50°W 54.85' FENCE POST, S45°E 54.60' FENCE POST
- 1982 JAMES A. RAY PS#25869 SURVEY IN SEC.25, L.1, P.934 FD. 1/2" IRON SOUTH 62.10' 12" MAPLE, S43°E 54.52' F. POST, S60°W 54.82' F. POST
- 1994 J. DEAN GEERS PS#33977 FOUND IRON 2' SOUTH OF CL ROAD SET 5/8" X 36" IRON IN MON BOX N60°E 74.38' 3" ELM, N30°W 47.72' 3" MAPLE, S75°W 95.59' 3" ELM, N78°E 129.15' 5" ELM

B. Description of corner evidence found and/or method applied in restoring or reestablishing corner:

- L-9 FOUND 5/8" IRON IN MONUMENT BOX IN CENTERLINE 48 ROAD. ADDED WEXFORD COUNTY BRASS CAP. THIS CORNER IS ACCEPTED AS THE BEST AVAILABLE EVIDENCE OF THE POSITION OF THE CORNER.

C. Description of monument for corner and accessories established to perpetuate locating the position of the corner:

- L-9 1/4 CORNER COMMON TO SECTIONS 24 & 25 T21N, R9W
- 5/8" X 36" IRON AND BRASS CAP STAMPED: 1/4, 24, 25, 39095, 1999
- N54°E 5" ELM 58.13'
- N58°E 6" ELM 74.33'
- N33°W 9" ELM 47.31'
- S72°W 14" ELM 95.42'

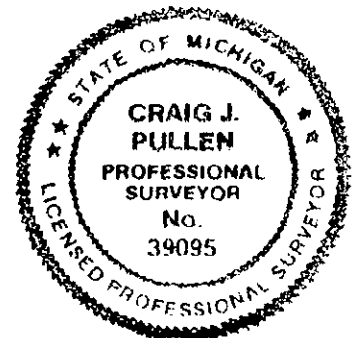

Peer Group Reviewed and Approved

Date: 12 Nov 99  
*Richard D. Wilcox*  
Richard D. Wilcox, Wexford County Surveyor

Signed by Craig J. Pullen Date OCTOBER 21, 1999

Surveyor's Michigan License No. 39095