

SURVEY & REMONUMENTATION

MAY 10 2000

RECEIVED

LAND CORNER RECORDATION CERTIFICATE 1999 DEC -3 PM 12: 44
Filing Requirement of Act 74, Mich. P.A. 1970

SECTION

For corners in

Linda Loughmiller
WEXFORD COUNTY, MI
REGISTER OF DEEDS

<u>WEXFORD</u> (County)	Located In:	Corner Code #
1. Public Land Survey	T 21N R 9W	L-11
	T R	
	T R	
	T R	
2. Property Controlling in Section	S T R	
	S T R	
3. Miscellaneous Property in Sec.	S T R	
	S T R	
4. Lot No. _____, Recorded Plat _____		
5. Private Claims _____		

Register of Deeds Stamp & File Number

A	B	C	D	E	F	G	H	I	J	K	L	M
1												
2	6	5	4	3	2	1						
3												
4	7	8	9	10	11	12						
5												
6	18	17	16	15	14	13						
7												
8	19	20	21	22	23	24						
9												
10	30	29	28	27	26	25						
11												
12	31	32	33	34	35	36						
13												

I, CRAIG J. PULLEN, PS, in a field survey on AUGUST 13, 1999, do hereby state that under requirements of P.A. 74, Michigan P.A. of 1970, the corner points mentioned in lines 1 and 2 above were in conformance with regulations and rules therefore as required in the current manual of survey instructions of the United States Department of the Interior, Bureau of Land Management or by a decree of a Court of Law and/or that the corner points mentioned in lines 3, 4 and 5 above were in conformance with the rules of the Michigan Board of Land Surveyors or by a Decree of a Court of Law; established, re-established, monumented, recovered, found as expressed below:

NOTE: Not more than 2 corners, all in the same town and range, may be recorded on this certificate.

A. Description of original monument and accessories and/or subsequent restoration:


- L-11 1848 G.L.O. RESURVEY BY O. LYON, WOOD POST, SUGAR 8 N31/4W 19, SUGAR 9 S141/2W 14
- 1898 A. J. TEED FENCE POST SW 57 DISTANCE TO SW COR. 2632.74', DISTANCE TO SE COR. 2630.10'
- 1899 D. E. TEED SURVEY IN SEC.36, CORNER SHOWN, NO WITNESSES
- UNDATED OLD CO. WITNESS BOOK 1" PIPE 30" ELM N70W 153.00, 8" ELM N60W 75.85, 20" MAPLE S10E 170.00 CLUMP 6" ELM N60E 85.00
- 1971 W.C.R.C. WITNESS BOOK 3/4" ROD W/WOOD STAKE F.P. N05°W 26.40' 4" PINE S10°E 40.30', P.P. S20°W 75.20'
- 1982 JAMES A. RAY PS#25869 SURVEY IN SEC.25, L.1, P.933 & 934 FD PIPE WITNESSES IN CO. BOOK OK

B. Description of corner evidence found and/or method applied in restoring or reestablishing corner:

- L-11 FOUND 3/4" PIPE AND SHARPENED CEDAR POST IN CENTERLINE OF 50 ROAD AND FENCE POST WITNESS FROM 1971. REPLACED WITH 5/8" X 36" IRON AND WEX. CO. BRASS CAP. DISTANCE TO SW CORNER IS 2631.15' (2632.74'-TEED). THIS CORNER IS ACCEPTED AS THE BEST AVAILABLE EVIDENCE OF THE POSITION OF THE CORNER.

C. Description of monument for corner and accessories established to perpetuate locating the position of the corner:

- L-11 1/4 CORNER COMMON TO SECTIONS 25 & 36 T21N, R9W
- 5/8" X 36" IRON AND BRASS CAP STAMPED: CJP, 39095, 1999, 1/4, 25, 36
- NORTH CORNER FENCE POST 26.73'
- N12°E 14" RED PINE 47.90'
- S43°E CORNER FENCE POST 36.80'
- S20°E 9" RED PINE 35.91'

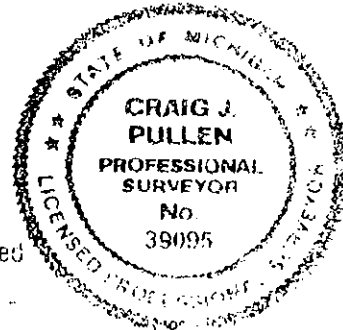

Peer Group Reviewed and Approved
Date: 12 Nov 99
Richard D. Wilcox
Richard D. Wilcox, Wexford County Surveyor

Signed by *Craig J. Pullen* Date OCTOBER 7, 1999
Surveyor's Michigan License No. 39095