

APR 16 1999

1998 DEC 30 PM 2: 10

LAND CORNER RECORDATION CERTIFICATE
Filing Requirement of Act 74, Mich. P.A. 1970

Linda Loughmiller
WEXFORD COUNTY, MI
REGISTER OF DEEDS

For corners in SECTION

Wexford (County)	Located In:	Corner Code #
1. Public Land Survey	T <u>21N</u> R <u>09W</u>	<u>M-8</u>
	T _____ R _____	_____
	T _____ R _____	_____
	T _____ R _____	_____
2. Property Controlling in Section	S _____ T _____ R _____	_____
	S _____ T _____ R _____	_____
3. Miscellaneous Property in Sec.	S _____ T _____ R _____	_____
	S _____ T _____ R _____	_____

Register of Deeds Stamp & File Number

4. Lot No. _____, Recorded Plat _____
5. Private Claims _____

I, George D. Smith, P.S., in a field survey on May 22, 19 98 do hereby state that under requirements of P.A. 74, Michigan P.A. of 1970, the corner points mentioned in lines 1 and 2 above were in conformance with regulations and rules therefore as required in the current manual of survey instructions of the United States Department of the Interior, Bureau of Land Management or by a decree of a Court of Law and /or that the corner points mentioned in lines 3, 4 and 5 above were in conformance with the rules of the Michigan Board of Land Surveyors or by a Decree of a Court of Law; established, re-established, monumented, recovered, found as expressed below:

	A	B	C	D	E	F	G	H	I	J	K	L	M
1													
2		6		5		4		3		2		1	
3													
4		7		8		9		10		11		12	
5													
6		18		17		16		15		14		13	
7													
8		19		20		21		22		23		24	
9													
10		30		29		28		27		26		25	
11													
12		31		32		33		34		35		36	
13													

NOTE: Not more than 2 corners, all in the same town and range, may be recorded on this certificate.

A. Description of original monument and accessories and/or subsequent restoration:

- M-8) 1837 GLO Quarter Section Post by John Brink, Deputy Surveyor; Sugar 10-S72W-08; Hemlock 8-N51W-21
- M-8) 1891 A.J. Teed; Survey Liber 1, Page 40; Old stake lost, established new corner on line 2-3 at 1/2 distance; Elm 6-S34 3/4E-72, put in cedar stake and stone.
- M-8) 1893 Beuthien Survey in Section 19, T21N, R8W. Corner found and used to breakdown Section 19, no description or witnesses given.

B. Description of corner evidence found and/or method applied in restoring or reestablishing corner:

Found large pointed stone and remains of cedar stake opposite fence line to East that matched Teed's 1891 witness of a 6" Elm-S34 3/4E-72' (47.52'). Position of Teed's corner measures 1.8' East and 1' North of calculated midpoint and is accepted as a careful and faithful re-establishment of the position of the original corner being the quarter corner common to Section 24, T21N, R9W and Section 19, T21N, R8W.


C. Description of monument for corner and accessories established to perpetuate locating the position of the corner:

Set Wexford County Monument with brass cap stamped East 1/4 24, 1998 PS 39098 in center of Cedar stake on Northeast side of stone.

- S85E 34.70' Corner fence post
- N30W 47.75' 20" Box elder
- N30E 55.45' 10" Elm
- N74W 40.35' Corner fence post
- S34E 47.3' 30" Elm stump (6" Elm 47.52' Teed)

Peer Group Reviewed and Approved
Date: December 1998
Richard D. Wilcox
Richard D. Wilcox, Wexford County Surveyor

Signed by _____
Surveyor's Michigan License No. 39098

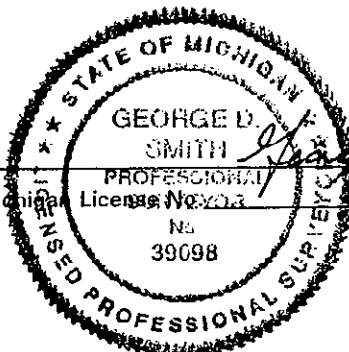

Date 12-9-98