

OUTLET
REMOVAL

MAR 31 1994

COMMISSION

LAND CORNER RECORDATION CERTIFICATE
Filing Requirement of Act 74, Mich. P.A. 1970

RECEIVED

1993 DEC -2 PM 3:51

For corners in
WEXFORD
(County)

Located In: Corner Code --#

- 1. Public Land Survey T 21N R 9W M-13
- T _____ R _____
- T _____ R _____
- T _____ R _____
- 2. Property Controlling S _____ T _____ R _____
- in Section S _____ T _____ R _____
- 3. Miscellaneous S _____ T _____ R _____
- Property in Sec. S _____ T _____ R _____

Linda Laughmiller
WEXFORD COUNTY, MI
REGISTER OF DEEDS

Register of Deeds Stamp & File Number

- 4. Lot No. _____, Recorded Plat _____
- 5. Private Claims _____

	A	B	C	D	E	F	G	H	I	J	K	L	M
2	6	5	4	3	2	1							
3													
4	7	8	9	10	11	12							
5													
6	18	17	16	15	14	13							
7													
8	19	20	21	22	23	24							
9													
10	30	29	28	27	26	25							
11													
12	31	32	33	34	35	36							
13													

I, CRAIG J. PULLEN, in a field survey on OCTOBER 13, 1993, do hereby certify that under requirements of P.A. 74, Michigan P.A. of 1970, the corner points mentioned in lines 1 and 2 above were in conformance with regulations and rules therefore as required in the current manual of survey instructions of the United States Department of the Interior, Bureau of Land Management or by a decree of a Court of Law and/or that the corner points mentioned in lines 3, 4 and 5 above were in conformance with the rules of the Michigan Board of Land Surveyors or by a Decree of a Court of Law; established, re-established, monumented, re-monumented, recovered, found as expressed below:


NOTE: Not more than 4 corners, all in the same town and range, may be recorded on this certificate.

A. Description of original monument and accessories and/or subsequent restoration:

- M-13 1837 GLO SURVEY BY J. BRINK, WOOD POST B. ASH 12" N46°E 25L HEMLOCK 12" N55°W 17L
- 1899 D.E. TEED SURVEY, FOUND FROM GOVERNMENT WITNESSES HEMLOCK 14" N15½°E 11L
- HEMLOCK 12" N29°E 55L MAPLE 4" S63°W 48L
- 1985 GRANGER ENGINEERING SURVEY, CORNER RECORDED IN L.3, P.368, SET WEXFORD CO. MONUMENT FROM MAPLE TREE WITNESS IN D.E. TEED NOTES DATED 1901 IN OLD BOOK IN WEXFORD COUNTY COURTHOUSE N60°W 4" TWIN MAPLE 3.60' S50°W 10" CEDAR 18.90' S85°W 4" IRON WOOD 31.20' S30°E WD. GATE POST 42.00' N45°E FE. POST 34.40'

B. Description of corner evidence found and/or method applied in restoring or reestablishing corner:

- M-13 FOUND WEXFORD COUNTY MONUMENT IN GOOD CONDITION AND WITNESSES FROM LIBER 3, PAGE 368 INTACT. THIS CORNER IS ACCEPTED AS A CAREFUL AND FAITHFUL PERPETUATION OF THE POSITION OF THE ORIGINAL CORNER.

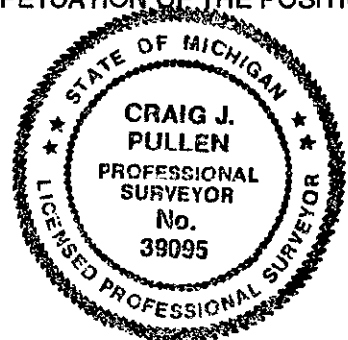

C. Description of monument for corner and accessories established to perpetuate locating the position of the corner:

- M-13 SE CORNER OF SECTION 36, T21N, R9W
- WEXFORD COUNTY MONUMENT
- N60°W 4" TWIN MAPLE 3.60'
- S50°W 10" CEDAR 18.90'
- S85°W 4" IRON WOOD 31.20'
- S30°E WOOD GATE POST 42.00'
- N45°E FENCE POST 34.40'

Peer Group Reviewed and Approved
Date: Nov. 29, 1993
Richard D. Wilcox
Richard D. Wilcox, Wexford County Surveyor

Signed by Craig J. Pullen Date NOVEMBER 23, 1993
Surveyor's Michigan License No. 39095