

MICHIGAN
DEPARTMENT OF CONSERVATION
FORESTRY DIVISION

LAND CORNER RECORD

T. 21 N. R. 10W


Wexford COUNTY

DESCRIPTION OF CORNER Section corner common to Sections 25-26-35-36

CORNER MONUMENT Set 1" pipe with 4" aluminum cap

DATE MONUMENT PLACED AND WITNESSED 10/31/61

WITNESSES TO CORNER.....

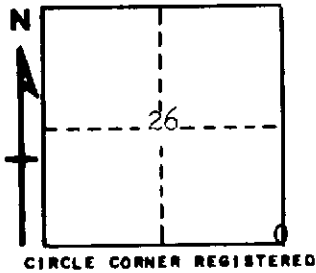

30" W. Pine stub - S 55 W - 92.6 feet

* 30" W. Pine stump - S 37 E - 19.2 feet

AND

* Sour NET

DESCRIPTION IN DETAIL AS TO HOW CORNER WAS LOCATED AND IDENTIFIED OR RESTORED.

This corner was found by Forestry Division personnel during forest management work in this area. Found squared cedar post at corner and 1 $\frac{1}{4}$ " pipe, as established by County Surveyor Sours, probably in early 1900's, and of record in County Courthouse. Both his new bearing trees in place, but nothing for U.S. bearing trees.

SURVEYOR'S SEAL

SIGNED Kenneth J. Ostberg DATE 11/14/61
REGISTERED LAND SURVEYOR