

LAND CORNER RECORDATION CERTIFICATE
Filing Requirement of Act 74, Mich. P.A. 1970

For corners in

WEXFORD
 (County)

Located In:

Corner Code ~~##~~

- | | | | | | |
|------------------------------------|---|------------|---|------------|-------------------|
| 1. Public Land Survey | T | <u>21N</u> | R | <u>10W</u> | <u>K-12, L-11</u> |
| | T | | R | | <u>M-11</u> |
| | T | | R | | |
| | T | | R | | |
| 2. Property Controlling in Section | S | <u>36</u> | T | R | <u>3</u> |
| | S | | T | R | |
| 3. Miscellaneous Property in Sec. | S | | T | R | |
| | S | | T | R | |

Register of Deeds Stamp & File Number

4. Lot No. _____, Recorded Plat _____
5. Private Claims _____

I, CARL F. ROSER, in a field survey on 2-28, 19 91, do hereby certify that under requirements of P.A. 74, Michigan P.A. of 1970, the corner points mentioned in lines 1 and 2 above were in conformance with regulations and rules therefore as required in the current manual of survey instructions of the United States Department of the Interior, Bureau of Land Management or by a decree of a Court of Law and/or that the corner points mentioned in lines 3, 4 and 5 above were in conformance with the rules of the Michigan Board of Land Surveyors or by a Decree of a Court of Law; established, re-established, monumented, re-monumented, recovered, found as expressed below:

NOTE: Not more than 4 corners, all in the same town and range, may be recorded on this certificate.

A	B	C	D	E	F	G	H	I	J	K	L	M
2	6	5	4	3	2	1						
3												
4	7	8	9	10	11	12						
5												
6	18	17	16	15	14	13						
7												
8	19	20	21	22	23	24						
9												
10	30	29	28	27	26	25						
11												
12	31	32	33	34	35	36						
13												


A. Description of original monument and accessories and/or subsequent restoration:

K-12

L-11

M-11

3

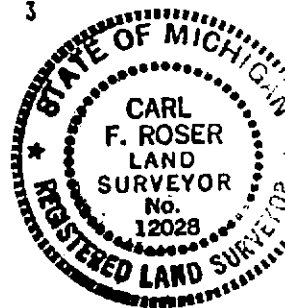

B. Description of corner evidence found and/or method applied in restoring or reestablishing corner:

K-12

L-11

M-11

3

FD DEPT MON FOR NW 1/4 COR SEC 36 AS SET BY K. OSTLING IN 1961 DEPT SURVEY. OSTLING FD SQ CEDAR POST ESTABLISHED BY CO SURVEYOR SOURS; PROBABLY IN EARLY 1900'S. CTR TRAIL RD (NE-SW) IS E 7'±.

FD DEPT MON FOR NW 1/4 COR S-36 AS SET BY LS K. OSTLING IN 1961 DEPT SURVEY. COR WAS SET AT FD SQ CED POST THAT FITS TWO U.S. BEARING TREES. OLD E-W FN REMAINS DUE S. 8'±.

FD 1/2" IRON FOR NE COR S-36 AS ESTABLISHED BY RLS J. ERICKSON IN 1973 SURVEY. COR IS AT SOUTH END OF GRAVEL RD FROM NORTH AND IN LINE W/FN SOUTH. J. E. RE-ESTAB. SEC COR AT FN COR INTERSECTION E-W-S. IN 1973.

ESTABLISHED NW COR OF SW 1/4-NW 1/4 OF S-36 PER STANDARD B.L.M. INSTRUCTIONS.

C. Description of monument for corner and accessories established to perpetuate locating the position of the corner:

K-12

L-11

M-11

3

FD CONSERVATION DEPT MON; ADDED CED POST.
 12" MAPLE S50°E 22.6'
 5" MAPLE S85°W 29.6'
 3" MAPLE IN CLUMP 4 N60°W 31.9'
 21" R. OAK N30°E 56.1'

FD CONSERVATION DEPT MON & SQ POST; ADDED NEW CED POST.
 7" CEDAR N65°W 6.12'
 6" CEDAR N55°E 15.37'
 8" CEDAR S15°E 36.5'
 8" CEDAR S40°W 17.6'

FD 1/2" IRON W/LS CAP #16929.
 *P POLE S74°W 31.48'
 *TREATED FN POST EAST 4.89'
 4" CHERRY N28°W 50.44'
 TREATED FN POST SOUTH 0.45'

DROVE 5/8"x 3/4" RE-ROD W/RLS CAP; SET CED POST W/LOC TAG.
 10" R. OAK W/17"
 R. OAK N40°E 21.8'
 13" MAPLE S25°W 13.4'
 9" MAPLE IN CLUMP 4 DUE W 22.4'

* = J. E. (N&E) WIT.

Signed by Carl F. Roser 03-16-91 Date _____
 12028