

SURVEY & MONUMENT

RECEIVED

LAND CORNER RECORDATION CERTIFICATE

1993 DEC -2 PM 3 50

MAR 31 1994

FILING REQUIREMENT OF ACT 74, MICH. P.A. 1970

COMMISSION

Linda Loughmiller  
WEXFORD COUNTY, MI  
REGISTER OF DEEDS

FOR CORNERS OF:-	LOCATED IN:-	CORNER CODE NUMBER
1. PUBLIC LAND SURVEY	T. <u>21N</u> N. S., R. <u>10W</u> E. W.	B-13, <u>C-13</u>
2. PROPERTY CONTROLLING IN SECTION	T. _____ N. S., R. _____ E. W.	
3. MISCELLANEOUS PROPERTY IN SECTION	T. _____ N. S., R. _____ E. W.	
4. LOT NO. _____, RECORDED PLAT _____		
5. PRIVATE CLAIMS _____		

REGISTER OF DEEDS STAMP AND FILING NUMBER

I, CRAIG J. PULLEN do hereby certify that under requirements of P.A. 74, Michigan P.A. of 1970, the corner points mentioned in lines 1 and 2 above (identified with circles on index code diagram - over) were, in a field survey on SEPTEMBER 17 1993, established, re-established, monumented, re-monumented, recovered or restored as expressed below and in conformance with regulations and rules therefore as required in the current manual of survey instructions of the United States Department of the Interior, Bureau of Land Management or by a decree of a court of law. Furthermore, that the corner points mentioned in lines 3, 4 and 5 above were, in a field survey on \_\_\_\_\_ 19\_\_\_\_, found, recovered, restored, established or re-established as expressed below and in conformance with the rules of the Michigan State Board of Registration for Land Surveyors or, by a Decree of a Court of law:

Peer Group Reviewed and Approved

Date: 11-29-93

A. Description of original monument and accessories and/or subsequent restoration: Richard D. Wilcox, Wexford County Surveyor

- B-13 1837 ORIGINAL GOVERNMENT SURVEY BY JOHN BRINK. WOOD POST. SPRUCE 10" N41°E 21L SPRUCE 10" N12°W 6L.
- 1990 P. LEEMON REC. CORNER IN L.4, P.58. SET 5"X60" CONC. MON. BY SINGLE PROPORTIONATE MEAS. BETWEEN SW 31 AND S¼ 32.
- C-13 1837 ORIGINAL GOVERNMENT SURVEY BY JOHN BRINK. BEECH 10" N56°E 45L BEECH 8" N63°W 38L.
- 1990 P. LEEMON, PS #31595 RECORDED CORNER IN L.4, P.58. SET 5"X60" CONC. MON. WITH BRASS CAP BY SINGLE PROPORTIONATE MEASURE BETWEEN SW 31 AND S¼ 32.

B. Description of corner evidence found and/or method applied in restoring or re-establishing corner:


- B-13 LEEMON SET THIS CORNER BY SINGLE PROP. MEAS. BETWEEN THE S¼ COR. 32 AND SW COR. 31. AFTER REVIEWING THE S¼ OF 32 WITH HIM, AND SUBSEQUENTLY NOT USING IT, THIS LOCATION THEN BECAME INVALID. AFTER A CAREFUL SEARCH FOR EVIDENCE OF THE ORIGINAL CORNER AND ITS ACCESSORIES, I FOUND REMAINS OF WOOD POST IN BOG FITTING GLO SWAMP CALLS. SET 5" X 5" X 60" CONCRETE MONUMENT AND BRASS CAP.
- C-13 LEEMON SET THIS CORNER BY SINGLE PROP. MEAS. BETWEEN THE S¼ COR. 32 AND SW COR. 31. AFTER REVIEWING THE S¼ OF 32 WITH HIM, AND SUBSEQUENTLY NOT USING IT, THIS LOCATION THEN BECAME INVALID. AFTER A CAREFUL SEARCH FOR EVIDENCE OF THE ORIGINAL CORNER AND ITS ACCESSORIES, I FOUND REMAINS OF CEDAR AND STAKE 8" X 10" X 10" STONE AND OLD WOOD POST IN EAST-WEST FENCE LINE. SET 5" X 5" X 60" CONCRETE MONUMENT AND BRASS CAP.

C. Description of monument for corner and accessories established to perpetuate locating the position of the corner:

B-13 S¼ COR., SECTION 31, T21N, R10W	C-13 COR. COMMON TO SEC. 31 & 32, T21N, R10W
SET 5" X 5" X 60" CONC. MON. & U.S.F.S. BRASS CAP	SET 5" X 5" X 60" CONC. MON. & U.S.F.S. BRASS CAP
N6°E 12" WHITE PINE 159.59'	N78°W 18" RED PINE 28.78'
N49°E 10" WHITE PINE 160.70'	N5°W 16" RED PINE 62.89'
N28°W 8" WHITE PINE BLAZED ON N SIDE 26.63'	N43°E 14" RED PINE 55.71'
N35°W 9" WHITE PINE BLAZED ON E SIDE 83.78'	S78°E 32" RED OAK 60.47'
N79°E 10" WHITE PINE 20.30'	NORTH CARSONITE 0.3'
S34°W 8" WHITE PINE 80.44'	

SIGNED BY Craig J. Pullen DATE 12/29/93

SURVEYOR'S MICHIGAN REGISTRATION NO. 39095

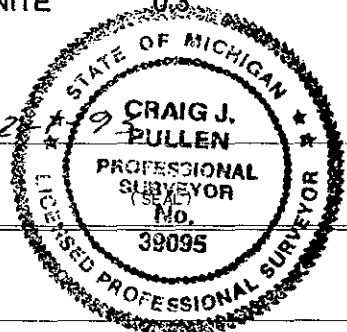

FOR STATE AND UNITED STATES AGENCIES:

SIGNED BY \_\_\_\_\_ DATE \_\_\_\_\_

APPROVED AND SIGNED BY Richard D. Wilcox MICHIGAN REGISTERED LAND SURVEYOR DATE 11/22/93 (SEAL)

SURVEYOR'S MICHIGAN REGISTRATION NO. 31595