

MAR 31 1994

LAND CORNER RECORDATION CERTIFICATE
Filing Requirement of Act 74, Mich. P.A. 1970

1993 DEC -2 PM 3:51

For corners in
WEXFORD
(County)

Linda Loughmiller
WEXFORD COUNTY, MI
REGISTER OF DEEDS

Located In: Corner Code #

- 1. Public Land Survey T 21N R 10W K-13
T _____ R _____
T _____ R _____
T _____ R _____
- 2. Property Controlling S _____ T _____ R _____
in Section S _____ T _____ R _____
- 3. Miscellaneous S _____ T _____ R _____
Property in Sec. S _____ T _____ R _____
- 4. Lot No. _____, Recorded Plat _____
- 5. Private Claims _____

Register of Deeds Stamp & File Number

I, CRAIG J. PULLEN, in a field survey on OCTOBER 13, 1993, do hereby certify that under requirements of P.A. 74, Michigan P.A. of 1970, the corner points mentioned in lines 1 and 2 above were in conformance with regulations and rules therefore as required in the current manual of survey instructions of the United States Department of the Interior, Bureau of Land Management or by a decree of a Court of Law and/or that the corner points mentioned in lines 3, 4 and 5 above were in conformance with the rules of the Michigan Board of Land Surveyors or by a Decree of a Court of Law; established, re-established, monumented, re-monumented, recovered, found as expressed below:

	A	B	C	D	E	F	G	H	I	J	K	L	M
2	6	5	4	3	2	1							
3													
4	7	8	9	10	11	12							
5													
6	18	17	16	15	14	13							
7													
8	19	20	21	22	23	24							
9													
10	30	29	28	27	26	25							
11													
12	31	32	33	34	35	36							
13													


NOTE: Not more than 4 corners, all in the same town and range, may be recorded on this certificate.

A. Description of original monument and accessories and/or subsequent restoration:

- K-13 1837 GLO SURVEY, WOOD POST CEDAR 10" N10°E 20 LKS. CEDAR 12" N61°W 33 L.
- 1900± E. E. SOURS 4" CEDAR STAKE CEDAR 8" N26½°E 14.7' CEDAR 8" N42°W 16.5'
- 1961 K. OSTLING FOUND SQUARED POST AS ESTABLISHED BY E. E. SOURS. SET CONSERVATION DEPT. MONUMENT 7" CEDAR N66½°E 22.3' 8" CEDAR N6½°W 36.2'
- 1963 C. ROSER #12028 SURVEY, CORNER RECORDED IN L.2, P.868. FOUND 4" CEDAR STAKE & DEPT. OF CONSERVATION DISK ON PIPE AND WITNESSES INTACT.
- 1974 J. ERICKSON #16929 SURVEY, CORNER RECORDED IN L.2, P.674. FOUND DNR PIPE & POST DUE N 10" CEDAR 36.45' N40°E 8" CEDAR 3.60' S45°W 8" CEDAR 4.30'
- 1991 C. ROSER, SURVEY, CORNER RECORDED IN L.4, P.99, FOUND DEPT. MONUMENT AS ESTABLISHED BY K. OSTLING (1961) 8" CEDAR N53°W 26.7' 12" CEDAR N3°W 37.1' 10"X4' TALL SQUARED CEDAR STUMP N35°E 2.8' 9" CEDAR S45°W 3.7' E-W FENCE DUE S 19'

B. Description of corner evidence found and/or method applied in restoring or reestablishing corner:

- K-13 FOUND DNR MONUMENT ON PIPE AND 4" CEDAR POST 19' N OF E-W FENCE AND WITNESSES RECORDED IN L.4, P.99 INTACT. THIS CORNER IS ACCEPTED AS A CAREFUL AND FAITHFUL PERPETUATION OF THE POSITION OF THE ORIGINAL CORNER.

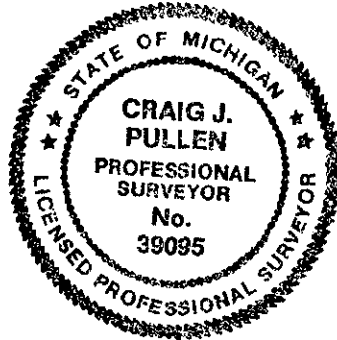

C. Description of monument for corner and accessories established to perpetuate locating the position of the corner:

- J-13 ALUMINUM DNR MONUMENT ON 1½" PIPE & CEDAR POST
- N53°W 8" CEDAR 26.70'
- N3°W 12" CEDAR 37.10'
- N35°E 10"X4' TALL SQUARED CEDAR STUMP 2.8'
- N67°E 10" CEDAR 22.60'
- S45°W 9" CEDAR 3.70'
- N6°W 10" DEAD CEDAR 36.45'

Peer Group Reviewed and Approved
Date: Nov. 29, 1993
Richard D. Wilcox
Richard D. Wilcox, Wexford County Surveyor

Signed by Craig J. Pullen Date NOVEMBER 23, 1993
Surveyor's Michigan License No. 39095