

MAY 29 1997

LAND CORNER RECORDATION CERTIFICATE

Filing Requirement of Act 74, Mich. P.A. 1970

COMMISSION

For corners in Wexford (County)

Located In:

Corner Code #

Table with 3 columns: Survey Type, T/R markers, and Corner Code #. Includes entries for Public Land Survey, Property Controlling in Section, and Miscellaneous Property in Section.

RECEIVED stamp dated 1996 DEC 13 PM 3:33, signature of Linda Loughmiller, WEXFORD COUNTY, MI REGISTER OF DEEDS, and Register of Deeds Stamp & File Number.

4. Lot No. Recorded Plat
5. Private Claims

I, George D. Smith, in a field survey on October 24, 1996, do hereby certify that under requirements of P.A. 74, Michigan P.A. of 1970, the corner points mentioned in lines 1 and 2 above were in conformance with regulations and rules therefore as required in the current manual of survey instructions of the United States Department of the Interior, Bureau of Land Management or by a decree of a Court of Law and/or that the corner points mentioned in lines 3, 4 and 5 above were in conformance with the rules of the Michigan Board of Professional Surveyors or by a Decree of a Court of Law; established, re-established, monumented, re-monumented, recovered, found as expressed below:

NOTE: Not more than 4 corners, all in the same town and range, may be recorded on this certificate.

A. Description of original monument and accessories and/or subsequent restoration:

- List of survey records from 1837 to 1987, including descriptions of quarter section posts, iron pipes, and certificates of survey.

B. Description of corner evidence found and/or method applied in restoring or reestablishing corner:

M-2) Found 5/8" Iron with DNR Cap in center of 1 1/4" Pipe and 1 witnesses from 1972 Batzer Survey. This corner is accepted as a careful and faithful re-establishment of the position of the original corner, being the 1/4 corner common to Section 1, T21N, R10W and Section 6, T21N, R9W


Peer Group Reviewed and Approved

Date: 14 Nov 96
Richard D. Wilcox, Wexford County Surveyor

C. Description of monument for corner and accessories established to perpetuate locating the position of the corner:

M-2) Replaced DNR cap with Wexford Co. brass cap stamped E 1/4, 1996 PS#39098

- List of monument bearings and distances: N54°E - 17.88' - 4" Maple, S45°W - 4.65' - 14" Maple, N14°W - 6.52' - 5" W. Pine, S38°E - 8.91' - 2" W. Pine

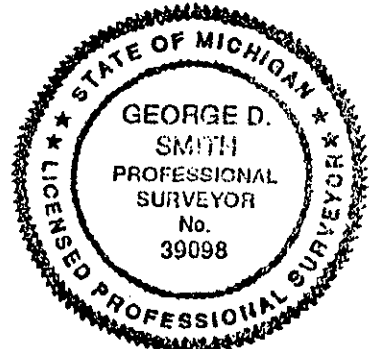

Signed by George D. Smith

Date 11-21-96

Surveyor's Michigan License No. #39098