

LAND CORNER RECORDATION CERTIFICATE
Filing Requirement of Act 74, Mich. P.A. 1970

For corners in Wexford Located In: _____ Corner Code # _____
 (County)

1. Public Land Survey	T	<u>21N</u>	R	<u>10W</u>	<u>M-10</u>
	T	_____	R	_____	_____
	T	_____	R	_____	_____
	T	_____	R	_____	_____
2. Property Controlling in Section	S	_____	T	_____	R
	S	_____	T	_____	R
3. Miscellaneous Property in Section	S	_____	T	_____	R
	S	_____	T	_____	R

4. Lot No. _____, Recorded Plat _____
 5. Private Claims _____

RECEIVED
 1996 DEC 13 PM 3:34
Linda Loughmiller
 WEXFORD COUNTY, MI
 REGISTER OF DEEDS
 Register of Deeds Stamp & File Number

I, George D. Smith, in a field survey on August 13, 1996, do hereby certify that under requirements of P.A. 74, Michigan P.A. of 1970, the corner points mentioned in lines 1 and 2 above were in conformance with regulations and rules therefore as required in the current manual of survey instructions of the United States Department of the Interior, Bureau of Land Management or by a decree of a Court of Law and/or that the corner points mentioned in lines 3, 4 and 5 above were in conformance with the rules of the Michigan Board of Professional Surveyors or by a Decree of a Court of Law; established, re-established, monumented, re-monumented, recovered, found as expressed below:

NOTE: Not more than 4 corners, all in the same town and range, may be recorded on this certificate.

A	B	C	D	E	F	G	H	I	J	K	L
2	6		5		4		3		2		1
3											
4	7		8		9		10		11		12
5											
6	16		17		16		15		14		13
7											
8	19		20		21		22		23		24
9											
10	30		29		28		27		26		25
11											
12	31		32		33		34		35		36
13											

A. Description of original monument and accessories and/or subsequent restoration:

M-10) 1837 GLO Quarter Section Post by John Brink, Deputy Surveyor, Beech 16 S32½°W 36, Birch 10 N15½°W 21
 1973 LCRC by J. Erickson, PS#16929, Liber 1, pg. 516, set 1/2" iron and cap in centerline road and opposite fence line to East. Witnesses on LCRC are incorrect.
 REMONUMENTATION

MAY 20 1997
 COMMISSION


B. Description of corner evidence found and/or method applied in restoring or reestablishing corner:

M-10) Found 1/2" iron of record ± Centerline Road North-South and in line with fence to East and ±8' North of Centerline 2-track to West. This position also fits 1/8th line fence to North within 2' and is accepted as the best available evidence of the position of the original corner, being the 1/4 corner common to Section 25, T21N, R10W and Section 30, T21N, R9W.

Peer Group Reviewed and Approved
 Date: 14 Nov 96
Richard D. Wilcox
 Richard D. Wilcox, Wexford County Surveyor

C. Description of monument for corner and accessories established to perpetuate locating the position of the corner:

M-10) Replaced 1/2" Iron with 5/8"x36" iron with Wexford Co. brass cap stamped: E 1/4 25, 1996 PS 39098
 N90°E - 48.72' - 14" Red Pine
 S50°W - 60.58' - 5" Red Pine
 S38°E - 52.34' - 4" Red Pine
 S62°E - 38.07' - 6"x6" Wood Post

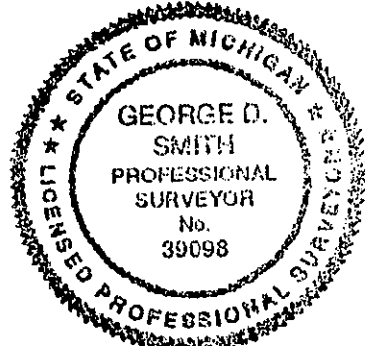

Signed by George D. Smith
 Surveyor's Michigan License No. #39098

Date 11-21-96