

LAND CORNER RECORDATION CERTIFICATE
Filing Requirement of Act 74, Mich. P.A. 1970

For corners in Wexford Located In: _____ Corner Code # _____
(County)

1. Public Land Survey	T	<u>21N</u>	R	<u>10W</u>	<u>M-11</u>
	T	_____	R	_____	_____
	T	_____	R	_____	_____
	T	_____	R	_____	_____
2. Property Controlling in Section	S	_____	T	_____	_____
	S	_____	T	_____	_____
3. Miscellaneous Property in Section	S	_____	T	_____	_____
	S	_____	T	_____	_____

4. Lot No. _____, Recorded Plat _____

5. Private Claims _____

RECEIVED
 1996 DEC 13 PM 3:34
RECEIVED
 Linda Loughmiller
 1996 DEC 13 PM 3:34
 WEXFORD COUNTY, MI
 REGISTER OF DEEDS
 Linda Loughmiller
 Register of Deeds Stamp & File Number
 WEXFORD COUNTY, MI
 REGISTER OF DEEDS

	A	B	C	D	E	F	G	H	I	J	K	L	M
2	6		5		4		3		2		1		
3													
4	7		8		9		10		11		12		
5													
6	18		17		16		15		14		13		
7													
8	19		20		21		22		23		24		
9													
10	30		29		28		27		26		25		
11													
12	31		32		33		34		35		36		
13													

I, George D. Smith, in a field survey on August 13, 19 96, do hereby certify that under requirements of P.A. 74, Michigan P.A. of 1970, the corner points mentioned in lines 1 and 2 above were in conformance with regulations and rules therefore as required in the current manual of survey instructions of the United States Department of the Interior, Bureau of Land Management or by a decree of a Court of Law and/or that the corner points mentioned in lines 3, 4 and 5 above were in conformance with the rules of the Michigan Board of Professional Surveyors or by a Decree of a Court of Law; established, re-established, monumented, re-monumented, recovered, found as expressed below:

NOTE: Not more than 4 corners, all in the same town and range, may be recorded on this certificate.

A. Description of original monument and accessories and/or subsequent restoration:

- M-11) 1837 GLO Quarter Section Post by John Brink, Deputy Surveyor, Beech 11 S 56° W 44, Beech 18 N 54° W 40
- 1892 D.E. Teed Survey, Liber 1, Page 49, found stake and 3 witnesses
- 1895 A. J. Teed Survey, Liber 1, Page 48 corner found, new witnesses W. Pine 30 S 29° E 51 links
- 1973 Wilcox Associates LCRC by J. Erickson RLS #16929, Liber 1, Page 512 set 1/2" iron and cap at fence corner intersections East-West and South, P.Pole S 85° W 31.48' South 0.25 12' treated corner fence post, East 4.89 6' treated post
- 1973 Wilcox Associates, Certificate of Survey by J. L. Wilcox RLS #14102 set 1/2" iron and cap
- 1991 LCRC by Carl Roser, RLS #12028, Found 1/2" iron set by Wilcox Associates, P.P. S 74° W 31.48', treated fence post East 4.89, 4" Cherry N 28° W 50.44', treated fence post South 0.45'

B. Description of corner evidence found and/or method applied in restoring or reestablishing corner:

- M-11) Found 1/2" Iron set by J. Erickson in 1973 at intersection of fences East-West and South, This corner is accepted as the best available evidence of the position of the original corner, being the section corner common to Sections 25 and 36, T21N, R10W and Sections 30 and 31, T21N, R9W


SURVEY &
 RE-MONUMENTATION
 MAY 23 1997
 COMMISSION

Peer Group Reviewed and Approved
 Date: 14 Nov 96
Richard D. Wilcox
 Richard D. Wilcox, Wexford County Surveyor

C. Description of monument for corner and accessories established to perpetuate locating the position of the corner:

- M-11) Replaced 1/2" w/Cap #16929 w/ 5/8" x 36" Iron with Wexford County brass cap stamped PS#39098, 1996 - SE25

- S80°W - 31.46' - P. Pole
- N85°W - 26.07' - Fence Post
- N85°W - 14.07' - 1" pipe in fence line West
- N25°W - 50.32' - 6" Cherry
- S 85°E - 4.89' - Fence Post

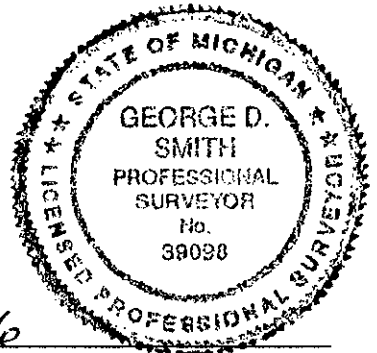

Signed by George D. Smith Date 11-21-96
 Surveyor's Michigan License No. #39098