

LAND CORNER RECORDATION CERTIFICATE
Filing Requirement of Act 74, Mich. P.A. 1970

For corners in
Wexford
(County)

Located In:

Corner Code #

1. Public Land Survey	T	<u>21</u> N	R	<u>10</u> W	<u>M-12</u>
	T	—	R	—	—
	T	—	R	—	—
	T	—	R	—	—
2. Property Controlling in Section	S	—	T	—	R
	S	—	T	—	R
3. Miscellaneous Property in Section	S	—	T	—	R
	S	—	T	—	R

RECEIVED
 1996 DEC 13 PM 3: 35
Linda Longmiller
 WEXFORD COUNTY, MI
 REGISTER OF DEEDS
Register of Deeds Stamp & File Number

4. Lot No. _____, Recorded Plat _____
 5. Private Claims _____

A	B	C	D	E	F	G	H	I	J	K	L
2	6	5	4	3	2	1					
3											
4	7	8	9	10	11	12					
5											
6	18	17	16	15	14	13					
7											
8	19	20	21	22	23	24					
9											
10	30	29	28	27	26	25					
11											
12	31	32	33	34	35	36					
13											

I, George D. Smith, in a field survey on November 9, 1996, do hereby certify that under requirements of P.A. 74, Michigan P.A. of 1970, the corner points mentioned in lines 1 and 2 above were in conformance with regulations and rules therefore as required in the current manual of survey instructions of the United States Department of the Interior, Bureau of Land Management or by a decree of a Court of Law and/or that the corner points mentioned in lines 3, 4 and 5 above were in conformance with the rules of the Michigan Board of Professional Surveyors or by a Decree of a Court of Law; established, re-established, monumented, re-monumented, recovered, found as expressed below:

NOTE: Not more than 4 corners, all in the same town and range, may be recorded on this certificate.

A. Description of original monument and accessories and/or subsequent restoration:

M-12) 1837 GLO Quarter Section Post by John Brink, Deputy Surveyor, Tamarack 4 N 52° W 85, Tamarack 5 S 63° W 140
 1973 Wilcox Associates LCRC by J.L. Wilcox RLS #14102, Liber 1, Page 83 set 1/2" iron pipe in water by single proportionate measure between re-established NE corner of Section 25 and found SE corner Section 36, no witnesses taken

B. Description of corner evidence found and/or method applied in restoring or reestablishing corner:


M-12) Found 1/2" iron as set in 1973 Wilcox Associates survey replaced with 1/2"x5' iron with Wexford Co. brass cap stamped: E 1/4 36, 1996 PS 39098. This position matches GLO swamp call to North within 1/2 chain and is accepted as a careful and faithful re-establishment of the position of the original corner being the 1/4 corner common to Section 36, T21N, R10W and Section 31, T21N, R10W.

SURVEY &
REMONUMENTATION
 MAY 20 1997
 COMMISSION

Peer Group Reviewed and Approved
 Date: 14 Nov 96
Richard D. Wilcox
 Richard D. Wilcox, Wexford County Surveyor

C. Description of monument for corner and accessories established to perpetuate locating the position of the corner:

M-12) 1/2" x5' iron with Wexford Co. brass cap. stamped E 1/4 36 1996 PS 39098.
 N32°W - 50.93' - 3" Tamarack
 N58°W - 47.58' - 2" Tamarack
 N68°W - 53.38' - 3" Tamarack
 N59°W - 28.97' - 3"x3" Wood Hub.

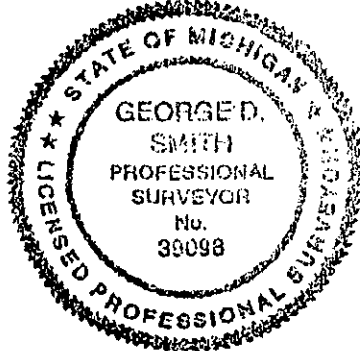

Signed by George D. Smith
 Surveyor's Michigan License No. #39098

Date 11-21-96