SURVEY & MONUMENTATION

MAR 3 1 1994

RECEIVED

1993 DEC 29 AM 10: 33

Linda Longmiller
WEXFORD COUNTY, MI
REGISTER OF DEEDS

LAND CORNER RECORDATION CERTIFICATE
Filing Requirement of Act 74, Mich. P.A. 1970

For corners in
WEXFORD
(County)

	Located In:	Corner Code #
1. Public Land Survey	T 21N R 10W	M-13
	T ___ R ___	
	T ___ R ___	
	T ___ R ___	
2. Property Controlling	S ___ T ___ R ___	
in Section	S ___ T ___ R ___	
3. Miscellaneous	S ___ T ___ R ___	
Property in Sec.	S ___ T ___ R ___	

Register of Deeds Stamp & File Number

4. Lot No. _____ , Recorded Plat _____
5. Private Claims _____

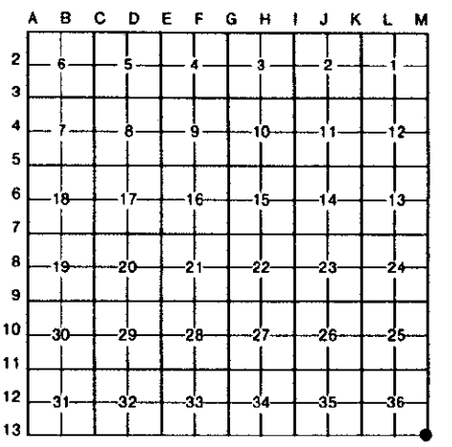

I, CRAIG J. PULLEN, in a field survey on DECEMBER 22, 19 93, do hereby certify that under requirements of P.A. 74, Michigan P.A. of 1970, the corner points mentioned in lines 1 and 2 above were in conformance with regulations and rules therefore as required in the current manual of survey instructions of the United States Department of the Interior, Bureau of Land Management or by a decree of a Court of Law and/or that the corner points mentioned in lines 3, 4 and 5 above were in conformance with the rules of the Michigan Board of Land Surveyors or by a Decree of a Court of Law; established, re-established, monumented, re-monumented, recovered, found as expressed below:

NOTE: Not more than 4 corners, all in the same town and range, may be recorded on this certificate.

A. Description of original monument and accessories and/or subsequent restoration:

M-13 1837 GLO SURVEY BY J. BRINK, WOOD POST HEMLOCK 10" N25½°W 10 LKS HEMLOCK N78°E 10 LKS

1963 C. ROSER, PS# 12028 SURVEY FOR MSHD, CORNER RECORDED IN L.2, P.866, SET 1" PIPE BY SINGLE PROPORTION 8" MAPLE N40°E 16.69' 7" BALSAM N84°E 20.59' 15" TWIN MAPLE N20°W 58.54' N¼ SECTION 1, T20N, R10W, N89°10'58"E 354.61'

1973 J. ERICKSON, PS# 16929 SURVEY, CORNER RECORDED IN L.1, P.510, FOUND 1" PIPE AND ROSER WITNESSES.

B. Description of corner evidence found and/or method applied in restoring or reestablishing corner:

M-13 FOUND 1" PIPE AND BOTH MAPLE WITNESSES INTACT FROM 1963 AND 1973. SET 5/8" X 36" IRON WITH BRASS CAP INSIDE 1" PIPE.

Peer Group Reviewed and Approved
Date: December 28, 1993
Richard D. Wilcox
Richard D. Wilcox, Wexford County Surveyor

C. Description of monument for corner and accessories established to perpetuate locating the position of the corner:

M-13 SE CORNER, SECTION 36, T21N, R10W
5/8" X 36" IRON WITH BRASS CAP STAMPED:
T21N, 36 R10W, 31 R9W, 1993, CJP 39095

N40°E	16"	MAPLE	16.65' (1963 WIT.)
N20°W		TWIN MAPLE 16" X 6"	58.54' (1963 WIT.)
S82°E	8"	MAPLE	17.81'
S46°W	10"	TWIN MAPLE	18.58'

STATE OF MICHIGAN
CRAIG J. PULLEN
PROFESSIONAL SURVEYOR
No. 39095
LICENSED PROFESSIONAL SURVEYOR

Signed by Craig J. Pullen Date DECEMBER 28, 1993
Surveyor's Michigan License No. 39095

FORM APPROVED BY MICHIGAN STATE BOARD OF LAND SURVEYORS, JAN. 28, 1971
REVISED MAY 14, 1975
REVISED JAN., 1983

LIBER 04 PAGE 215