

MAR 31 1994

COMMISSION

LAND CORNER RECORDATION CERTIFICATE  
Filing Requirement of Act 74, Mich. P.A. 1970

RECEIVED  
1993 DEC -2 PM 3:50

For corners in  
WEXFORD

(County)

Located In:

Corner Code #

- 1. Public Land Survey  
T 21N R 11W  
T 21N R 11W  
T \_\_\_\_\_ R \_\_\_\_\_  
T \_\_\_\_\_ R \_\_\_\_\_
- 2. Property Controlling in Section  
S \_\_\_\_\_ T \_\_\_\_\_ R \_\_\_\_\_  
S \_\_\_\_\_ T \_\_\_\_\_ R \_\_\_\_\_
- 3. Miscellaneous Property in Sec.  
S \_\_\_\_\_ T \_\_\_\_\_ R \_\_\_\_\_  
S \_\_\_\_\_ T \_\_\_\_\_ R \_\_\_\_\_
- 4. Lot No. \_\_\_\_\_, Recorded Plat \_\_\_\_\_
- 5. Private Claims \_\_\_\_\_

A-13 ✓  
B-13

*Linda Loughmiller*  
WEXFORD COUNTY, MI  
REGISTER OF DEEDS

Register of Deeds Stamp & File Number

	A	B	C	D	E	F	G	H	I	J	K	L	M
2	6		5		4		3		2		1		
3													
4	7		8		9		10		11		12		
5													
6	18		17		16		15		14		13		
7													
8	19		20		21		22		23		24		
9													
10	30		29		28		27		26		25		
11													
12	31		32		33		34		35		36		
13													

I, CRAIG J. PULLEN, in a field survey on OCTOBER 25, 1993, do hereby certify that under requirements of P.A. 74, Michigan P.A. of 1970, the corner points mentioned in lines 1 and 2 above were in conformance with regulations and rules therefore as required in the current manual of survey instructions of the United States Department of the Interior, Bureau of Land Management or by a decree of a Court of Law and/or that the corner points mentioned in lines 3, 4 and 5 above were in conformance with the rules of the Michigan Board of Land Surveyors or by a Decree of a Court of Law; established, re-established, monumented, re-monumented, recovered, found as expressed below:


NOTE: Not more than 4 corners, all in the same town and range, may be recorded on this certificate.

A. Description of original monument and accessories and/or subsequent restoration:

- A-13 1837 GLO SURVEY BY J. BRINK, WOOD POST BEECH 18" N10°E 25L HEMLOCK 22" N67°W 29L  
1966 R. GRIFFIN PS #13584 SURVEY, CORNER RECORDED IN L.1, P.404, FOUND RAILROAD RAIL AT INTERSECTION OF OLD FENCE E-W AND NORTH. REPLACED WITH 5" X 60" CONCRETE MONUMENT WITH U.S.F.S. BRASS CAP  
1976 MAPLE 2" N16°E 3.39' 5" MAPLE N86°E 71.75' 7" MAPLE N65°W 42.57' POST NORTH 1.1'  
GRANGER ENG. SURVEY RECORDED IN L.2, P.6, FOUND GRIFFIN MONUMENT AND WITNESSES
- B-13 1837 GLO SURVEY BY J. BRINK, WOOD POST SUGAR 10" N37°E 52L HEMLOCK 20" N15°W 5L  
1983 C. ROSER PS #12028 SURVEY, CORNER RECORDED IN L.3, P.304, SET WEXFORD COUNTY MONUMENT BY SINGLE PROP. 10" ASH N75°E 18.6' 5" W. PINE S15°E 10.7' 8" W. PINE S70°W 11.1' OLD F.S. LOC. POST S5°W 31'

B. Description of corner evidence found and/or method applied in restoring or reestablishing corner:

- A-13 FOUND 5" X 60" CONCRETE MONUMENT WITH U.S.F.S. BRASS CAP AND WITNESSES FROM L.1, P.404, INTACT. THIS CORNER IS ACCEPTED AS A CAREFUL AND FAITHFUL PERPETUATION OF THE POSITION OF THE ORIGINAL CORNER.
- B-13 FOUND WEXFORD COUNTY MONUMENT IN GOOD CONDITION AND WITNESSES FROM L.3, P.304, INTACT. THIS CORNER IS ACCEPTED AS A CAREFUL AND FAITHFUL PERPETUATION OF THE POSITION OF THE ORIGINAL CORNER.

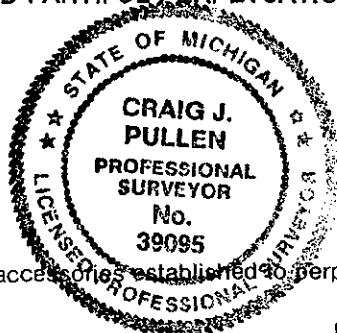

Peer Group Reviewed and Approved  
Date: Nov. 24, 1993  
*Richard D. Wilcox*  
Richard D. Wilcox, Wexford County Surveyor

C. Description of monument for corner and accessories established to perpetuate locating the position of the corner:

- A-13 SW COR. SEC.31, T21N, R11W  
FOUND 5" X 60" CONC. MON. WITH U.S.F.S. BRASS CAP  
N16°E 8" SUGAR MAPLE 3.39'  
N86°E 10" SUGAR MAPLE 71.75'  
N69°W 12" SUGAR MAPLE 42.57'  
NORTH CEDAR POST 1.1'  
S77°E 8" SUGAR MAPLE 15.94'
- B-13 S¼ COR. SEC.31, T21N, R11W  
FOUND WEXFORD CO. MON. 31' N OF OLD FENCE REMAINS  
EAST CEDAR POST 1.5'  
N70°E 16" ASH 18.60'  
S15°E 8" WHITE PINE 10.70'  
S66°W 10" WHITE PINE 11.10'  
S9°W OLD LOC. POST 31.00'  
N24°W 8" SUGAR MAPLE 35.09'

Signed by Craig J. Pullen  
Surveyor's Michigan License No. 39095

Date NOVEMBER 23, 1993