

MAR 8 1 1994

COMMISSION

LAND CORNER RECORDATION CERTIFICATE 1993 DEC -2 PM 3:50
Filing Requirement of Act 74, Mich. P.A. 1970

RECEIVED

For corners in
WEXFORD

(County)

Located in:

Corner Code #

1. Public Land Survey

T 21N R 11W
T 21N R 11W

G-13
D-13

2. Property Controlling in Section


S T R
S T R

3. Miscellaneous Property in Sec.

S T R
S T R

4. Lot No. , Recorded Plat

5. Private Claims

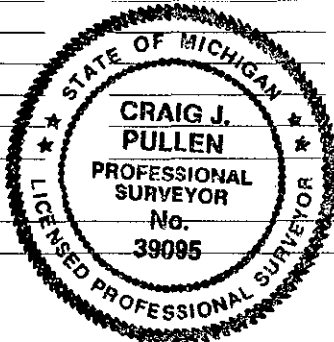

Linda Loughmiller
WEXFORD COUNTY, MI
REGISTER OF DEEDS

Register of Deeds Stamp & File Number

Grid with columns A-M and rows 2-13. Contains numbers 1-36 and two dots in row 13.

CRAIG J. PULLEN, in a field survey on OCTOBER 26, 1993

I, CRAIG J. PULLEN, in a field survey on OCTOBER 26, 1993, do hereby certify that under requirements of P.A. 74, Michigan P.A. of 1970, the corner points mentioned in lines 1 and 2 above were in conformance with regulations and rules therefore as required in the current manual of survey instructions of the United States Department of the Interior, Bureau of Land Management or by a decree of a Court of Law and/or that the corner points mentioned in lines 3, 4 and 5 above were in conformance with the rules of the Michigan Board of Land Surveyors or by a Decree of a Court of Law; established, re-established, monumented, re-monumented, recovered, found as expressed below:

NOTE: Not more than 4 corners, all in the same town and range, may be recorded on this certificate.

A. Description of original monument and accessories and/or subsequent restoration:

- C-13 1897 GLO SURVEY BY J. BRINK, WOOD POST BEECH 17" N80°W 28L HEMLOCK 22" N 71°E 10L 1913 E.E. SOURS SURVEY, SET CORNER BY MEAS. FROM SW CORNER AND NE CORNER, SECTION 31. FOUND HEMLOCK KNOT SQUARED WITH FOUR NOTCHES ON IT AND ROTTEN STAKE BESIDE IT. 1981 C. ROSE PS #12028 SURVEY, CORNER RECORDED IN L.3, P.304, SET DNR MONUMENT AND CEDAR POST ON LINE AND AT PRORATED DISTANCE TO SOUR'S SURVEY BETWEEN SW CORNER SECTION 31 AND SE CORNER SECTION 32 APPROX. OLD FENCE CORNER 12' NORTH AND 20' EAST FOUND OLD CEDAR POST WITH U.S.F.S. TAG MARKED SE 31 N65°W 13' 9" R. PINE N45°E 22.1' 7" R. PINE N75°E 35.8' 2'-10" SUGAR MAPLE S40°W 38.9'
- D-13 1897 GLO SURVEY BY J. BRINK, WOOD POST SUGAR 9" N22½°E 8L BEECH 10" N79°W 28L 1892 A.J. TEED SURVEY, FOUND GOVERNMENT WITNESSES AND PUT IN NEW STAKE. 1913 E.E. SOURS SURVEY, SET STAKE ON LINE MIDWAY BETWEEN SECTION CORNERS Y. BIRCH 6" S37½°W 32½' MAPLE 4" S23°E 67' 1981 C. ROSE PS #12028 SURVEY, CORNER RECORDED L.3, P.304, SET DNR MONUMENT AND CEDAR POST MIDWAY AND ON LINE BETWEEN SW AND SE CORNERS OF SECTION 32. APPROX. OLD FENCE CORNER POS. S77°E 16' (+5'). FOUND OLD CEDAR POST WITH U.S.F.S. LOC. TAG AT THIS LOCATION. 7" S. MAPLE N60°E 30.5' 13" S. MAPLE DUE S. 2.2' 6" MAPLE S35°W 32.7'

B. Description of corner evidence found and/or method applied in restoring or reestablishing corner:

- C-13 FOUND DNR MONUMENT ON PIPE AND WITNESSES FROM L.3, P.304 INTACT. OLD WITNESSES WERE TO FACE BLAZES, NEW WITNESSES ARE TO NAILS. THIS CORNER IS ACCEPTED AS A CAREFUL AND FAITHFUL PERPETUATION OF THE POSITION OF THE ORIGINAL CORNER.
- D-13 FOUND DNR MONUMENT ON PIPE AND WITNESSES FROM L.3, P.304. WITNESSES ARE TO FACE BLAZES, TWO ARE DEAD NOW. SET NAIL IN REMAINING LIVE TREE. THIS CORNER IS ACCEPTED AS A CAREFUL AND FAITHFUL PERPETUATION OF THE POSITION OF THE ORIGINAL CORNER.

Peer Group Reviewed and Approved
Date: Nov. 29, 1993
Richard D. Wilcox, Wexford County Surveyor

C. Description of monument for corner and accessories established to perpetuate locating the position of the corner:

- C-13 SW CORNER OF SECTION 32, T21N, R11W FOUND DNR MONUMENT ON PIPE S37°W 14" TWIN MAPLE 39.40' N70°E 12" RED PINE 36.15' N45°E 14" RED PINE 22.55' N45°E CENTER OF WOOD LOC. POST 1.1' N20°E 10" RED PINE 55.38'
- D-13 S¼ CORNER, SECTION 32, T21N, R11W FOUND DNR MONUMENT ON PIPE S38°W 8" MAPLE 33.00' SOUTH 13" MAPLE (NOW STUB) 2.2' TO BLAZE N60°E 6" MAPLE 30.5' TO BLAZE (NOW DEAD) S79°E 6" MAPLE 32.19' N22°W 8" MAPLE IN HEMLOCK CLUMP 55.45' N37°E 6" MAPLE 19.31' N45°W CTR OF CEDAR POST 1.1' S75°E OLD WOOD POST WITH LOC.TAG 16.0'

Signed by Craig J. Pullen
Surveyor's Michigan License No. 39095

Date NOVEMBER 23, 1993