

SURVEYOR
REMONUMENTATION

RECEIVED

MAR 31 1994

LAND CORNER RECORDATION CERTIFICATE
Filing Requirement of Act 74, Mich. P.A. 1970

1993 DEC 29 AM 10:33

For corners in WEXFORD
(County)

Located In: _____ Corner Code # G-13

Linda Loughmiller
WEXFORD COUNTY, MI
REGISTER OF DEEDS

- 1. Public Land Survey T 21N R 11W G-13
- T _____ R _____
- T _____ R _____
- T _____ R _____
- 2. Property Controlling S _____ T _____ R _____
- in Section S _____ T _____ R _____
- 3. Miscellaneous S _____ T _____ R _____
- Property in Sec. S _____ T _____ R _____

Register of Deeds Stamp & File Number

- 4. Lot No. _____, Recorded Plat _____
- 5. Private Claims _____

	A	B	C	D	E	F	G	H	I	J	K	L	M
2	6	5	4	3	2	1							
3													
4	7	8	9	10	11	12							
5													
6	18	17	16	15	14	13							
7													
8	19	20	21	22	23	24							
9													
10	30	29	28	27	26	25							
11													
12	31	32	33	34	35	36							
13													

I, CRAIG J. PULLEN, in a field survey on DECEMBER 16, 1993, do hereby certify that under requirements of P.A. 74, Michigan P.A. of 1970, the corner points mentioned in lines 1 and 2 above were in conformance with regulations and rules therefore as required in the current manual of survey instructions of the United States Department of the Interior, Bureau of Land Management or by a decree of a Court of Law and/or that the corner points mentioned in lines 3, 4 and 5 above were in conformance with the rules of the Michigan Board of Land Surveyors or by a Decree of a Court of Law; established, re-established, monumented, re-monumented, recovered, found as expressed below:

NOTE: Not more than 4 corners, all in the same town and range, may be recorded on this certificate.

A. Description of original monument and accessories and/or subsequent restoration:

G-13 1837 GLO SURVEY BY J. BRINK, WOOD POST BEECH 9" N45°W 5 LK WHITE PINE 13" N38°E 7 LK
 1913 E.E. SOURS SURVEY, HEMLOCK STUMP 30" N43°W 41.0' HEMLOCK STUMP 24" S88°15'W 43.8'
 1939 ROSENGREN SURVEY, IRON RAIL 18" W. PINE N30°E 40 LKS
 1992 P. LEEMON, PS #31595 SURVEY, FOUND 10" CLAY TILE R. PINE 10" S5°W 15.85' R. PINE 8" N85°W 19.50' W. PINE STP N30°E 40 LKS (1939 ROSENGREN) USFS POST ADJACENT R. PINE 10" N27°E 27.10' R. PINE 10" S63°E 46.75'


B. Description of corner evidence found and/or method applied in restoring or reestablishing corner:

G-13 FOUND 10" CLAY TILE AND LEEMON'S WITNESSES INTACT. SET 5/8" X 36" IRON WITH BRASS CAP IN CENTER OF TILE. THIS CORNER IS ACCEPTED AS A CAREFUL AND FAITHFUL PERPETUATION OF THE POSITION OF THE ORIGINAL CORNER.

Peer Group Reviewed and Approved
Date: December 28, 1993
Richard D. Wilcox
Richard D. Wilcox, Wexford County Surveyor

C. Description of monument for corner and accessories established to perpetuate locating the position of the corner:

G-13 SE CORNER, SEC.33, T21N, R11W
 5/8" X 36" IRON WITH BRASS CAP STAMPED: SC, 33, 34, 1993, CJP 39095
 IN CENTER OF 10" CLAY TILE, USFS POST ADJACENT
 RED PINE 10" S5°W 15.85'
 RED PINE 8" N85°W 19.50'
 WHITE PINE STUMP N30°E 40 LKS (1939 ROSENGREN)
 RED PINE 10" N27°E 27.10'
 RED PINE 10" S63°E 46.75'

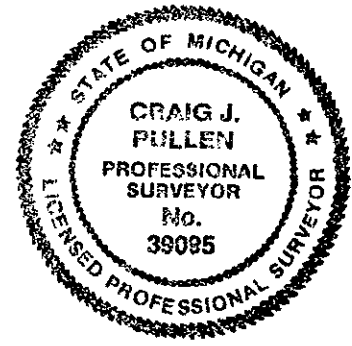

Signed by Craig J. Pullen Date DECEMBER 23, 1993

Surveyor's Michigan License No. 39095