

APR 16 1999

RECEIVED

1998 DEC 29 AM 10:42

SECTION

LAND CORNER RECORDATION CERTIFICATE  
Filing Requirement of Act 74, Mich. P.A. 1970

For corners in

*Linda Loughmiller*  
WEXFORD COUNTY, MI  
REGISTERED DEEDS

<u>WEXFORD</u> (County)	Located In:	Corner Code #
1. Public Land Survey	T <u>21N</u> R <u>11W</u>	<u>H-13</u>
	T _____ R _____	_____
	T _____ R _____	_____
	T _____ R _____	_____
2. Property Controlling in Section	S _____ T _____ R _____	_____
	S _____ T _____ R _____	_____
3. Miscellaneous Property in Sec.	S _____ T _____ R _____	_____
	S _____ T _____ R _____	_____
4. Lot No. _____, Recorded Plat _____		
5. Private Claims _____		

Register of Deeds Stamp & File Num

I, CRAIG J. PULLEN, PS, in a field survey on DECEMBER 7, 1998, do hereby state that under requirements of P.A. 74, Michigan P.A. of 1970, the corner points mentioned in lines 1 and 2 above were in conformance with regulations and rules therefore as required in the current manual of survey instructions of the United States Department of the Interior, Bureau of Land Management or by a decree of a Court of Law and/or that the corner points mentioned in lines 3, 4 and 5 above were in conformance with the rules of the Michigan Board of Land Surveyors or by a Decree of a Court of Law; established, re-established, monumented, recovered, found as expressed below:

1	A	B	C	D	E	F	G	H	I	J	K	L	M
2		6		5		4		3		2		1	
3													
4		7		8		9		10		11		12	
5													
6		18		17		16		15		14		13	
7													
8		19		20		21		22		23		24	
9													
10		30		29		28		27		26		25	
11													
12		31		32		33		34		35		36	
13													

NOTE: Not more than 2 corners, all in the same town and range, may be recorded on this certificate.

A. Description of original monument and accessories and/or subsequent restoration:

H-13 1837 G.L.O. SURVEY BY J. BRINK, WOOD POST, MAPLE 9 N33 1/2W 38, BEECH 10 N22 1/2E 52


B. Description of corner evidence found and/or method applied in restoring or reestablishing corner:

H-13 NO CORNER EVIDENCE OR WITNESSES FOUND. SET 5/8" X 36" IRON AND BRASS CAP BY SINGLE PROPORTIONATE MEASUREMENT BETWEEN THE SW CORNER OF SECTION 34 AND THE SE CORNER OF SECTION 36, T21N, R11W. THIS CORNER IS ACCEPTED AS A CAREFUL AND FAITHFUL RE-ESTABLISHMENT OF THE POSITION OF THE ORIGINAL CORNER.

C. Description of monument for corner and accessories established to perpetuate locating the position of the corner:

H-13 SOUTH 1/4 CORNER OF SECTION 34, T21N, R11W  
5/8"X36" IRON & BRASS CAP STAMPED: 1/4, 34, T21N, R11W, CJP, 1998, 39095  
N50°E 8" RED PINE 15.49'  
S14°E 7" RED PINE 7.12'  
S55°W 7" RED PINE 12.09'  
N32°W 13" RED PINE 9.31'

Peer Group Reviewed and Approved  
Date: 4 December 1998  
*Richard D. Wilcox*  
Richard D. Wilcox, Wexford County Surveyor

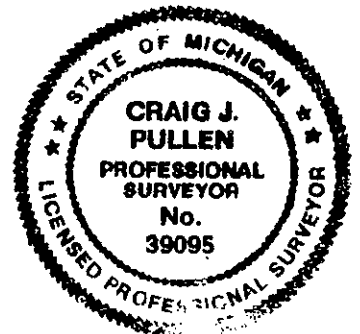

Signed by *Craig J. Pullen* Date December 18, 1998

Surveyor's Michigan License No. 39095 FORM APPROVED BY MICHIGAN STATE BOARD OF PROFESSIONAL SURVEYORS, JAN. 28, 1971