

APR 16 1999

SECTION

RECEIVED

1998 DEC 29 AM 10:42

LAND CORNER RECORDATION CERTIFICATE
Filing Requirement of Act 74, Mich. P.A. 1970

Linda Laughmiller
WEXFORD COUNTY, MI
REGISTER OF DEEDS

For corners in

Form with columns: WEXFORD (County), Located In:, Corner Code #. Includes sections for Public Land Survey, Property Controlling in Section, Miscellaneous Property in Sec., Lot No., and Private Claims.

Register of Deeds Stamp & File Number

Grid table with columns A-M and rows 1-13 for recording deed information.

I, CRAIG J. PULLEN, PS, in a field survey on DECEMBER 7, 1998, do hereby state that under requirements of P.A. 74, Michigan P.A. of 1970, the corner points mentioned in lines 1 and 2 above were in conformance with regulations and rules therefore as required in the current manual of survey instructions of the United States Department of the Interior, Bureau of Land Management or by a decree of a Court of Law and/or that the corner points mentioned in lines 3, 4 and 5 above were in conformance with the rules of the Michigan Board of Land Surveyors or by a Decree of a Court of Law; established, re-established, monumented, recovered, found as expressed below:

NOTE: Not more than 2 corners, all in the same town and range, may be recorded on this certificate.

A. Description of original monument and accessories and/or subsequent restoration:

J-13 1837 G.L.O. SURVEY BY J. BRINK, WOOD POST, MAPLE 9 N37W 19, BEECH 8 N18E 31


B. Description of corner evidence found and/or method applied in restoring or reestablishing corner:

J-13 NO CORNER EVIDENCE OR WITNESSES FOUND. SET 5/8" X 36" IRON AND BRASS CAP BY SINGLE PROPORTIONATE MEASUREMENT BETWEEN THE SW CORNER OF SECTION 34 AND THE SE CORNER OF SECTION 36, T21N, R11W. CORNER FALLS 100' SOUTH OF EAST-WEST 2 TRACK AND IN RED PINE PLANTATION. THIS CORNER IS ACCEPTED AS A CAREFUL AND FAITHFUL RE-ESTABLISHMENT OF THE POSITION OF THE ORIGINAL CORNER.

C. Description of monument for corner and accessories established to perpetuate locating the position of the corner:

J-13 SOUTH 1/4 CORNER OF SECTION 35, T21N, R11W
5/8"X36" IRON & BRASS CAP STAMPED: 1/4, 35, T21N, R11W, CJP, 1998, 39095
N53°E 8" RED PINE 9.11'
S54°E 9" JACK PINE 15.38'
S41°W 12" RED PINE 2.79'
N12°E 14" RED PINE 12.64'

Peer Group Reviewed and Approved
Date: December 1998
Richard D. Wilcox, Wexford County Surveyor

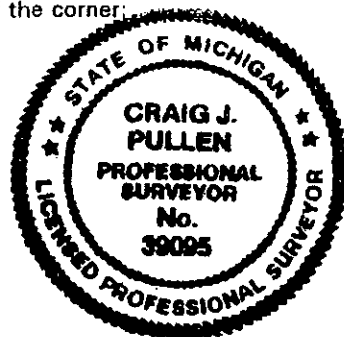

Signed by Craig J. Pullen Date December 17, 1998

Surveyor's Michigan License No. 39095