

SECTION

RECEIVED

1998 DEC 29 AM 10:42

LAND CORNER RECORDATION CERTIFICATE
Filing Requirement of Act 74, Mich. P.A. 1970

Linda Loughmiller
WEXFORD COUNTY, MI
REGISTER OF DEEDS

For corners in

<u>WEXFORD</u> (County)	Located In:	Corner Code #
1. Public Land Survey	T <u>21N</u> R <u>11W</u>	<u>L-13</u>
	T _____ R _____	_____
	T _____ R _____	_____
	T _____ R _____	_____
2. Property Controlling in Section	S _____ T _____ R _____	_____
	S _____ T _____ R _____	_____
3. Miscellaneous Property in Sec.	S _____ T _____ R _____	_____
	S _____ T _____ R _____	_____
4. Lot No. _____, Recorded Plat _____		
5. Private Claims _____		

Register of Deeds Stamp & File Number

A	B	C	D	E	F	G	H	I	J	K	L	M
1												
2	6		5		4		3		2		1	
3												
4	7		8		9		10		11		12	
5												
6	18		17		16		15		14		13	
7												
8	19		20		21		22		23		24	
9												
10	30		29		28		27		26		25	
11												
12	31		32		33		34		35		36	
13												

I, CRAIG J. PULLEN, PS, in a field survey on DECEMBER 7, 1998, do hereby state that under requirements of P.A. 74, Michigan P.A. of 1970, the corner points mentioned in lines 1 and 2 above were in conformance with regulations and rules therefore as required in the current manual of survey instructions of the United States Department of the Interior, Bureau of Land Management or by a decree of a Court of Law and/or that the corner points mentioned in lines 3, 4 and 5 above were in conformance with the rules of the Michigan Board of Land Surveyors or by a Decree of a Court of Law; established, re-established, monumented, recovered, found as expressed below:

NOTE: Not more than 2 corners, all in the same town and range, may be recorded on this certificate.

A. Description of original monument and accessories and/or subsequent restoration:

L-13 1837 G.L.O. SURVEY BY J. BRINK, WOOD POST, BEECH 11 S53 1/2W 15, BEECH 10 N17E 45


B. Description of corner evidence found and/or method applied in restoring or reestablishing corner:

L-13 NO CORNER EVIDENCE OR WITNESSES FOUND. SET 5/8" X 36" IRON AND BRASS CAP BY SINGLE PROPORTIONATE MEASUREMENT BETWEEN THE SW CORNER OF SECTION 34 AND THE SE CORNER OF SECTION 36, T21N, R11W. THE CORNER IS 550' SOUTH OF TRAIL ROAD. THIS CORNER IS ACCEPTED AS A CAREFUL AND FAITHFUL RE-ESTABLISHMENT OF THE POSITION OF THE ORIGINAL CORNER.

C. Description of monument for corner and accessories established to perpetuate locating the position of the corner:

L-13 SOUTH 1/4 CORNER OF SECTION 36, T21N, R11W
5/8" X 36" IRON & BRASS CAP STAMPED: 1/4, 36, CJP, 39095, 1998, T21N, R11W
N21°E 8" TRIPLE MAPLE 24.37'
S20°E 8" RED PINE 21.87'
S44°W 10" RED PINE 16.06'
N25°W 16" MAPLE 37.47'

Peer Group Reviewed and Approved
Date: December 1998
Richard D. Wilcox
Richard D. Wilcox, Wexford County Surveyor

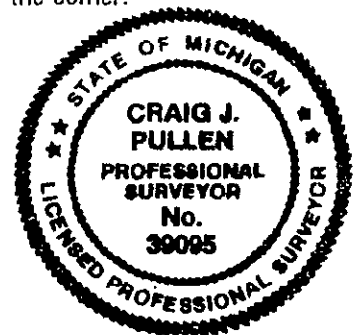

Signed by Craig J. Pullen Date December 18, 1998

Surveyor's Michigan License No. 39095