

JAN 17 1996

COMMISSION

LAND CORNER RECORDATION CERTIFICATE  
Filing Requirement of Act 74, Mich. P.A. 1970

RECEIVED

1995 NOV 13 PM 4: 26

*Linda Loughmiller*  
WEXFORD COUNTY, MI  
REGISTER OF DEEDS

For corners in  
WEXFORD

(County)

Located In:

Corner Code #

|                                    |   | 21N   | 11W   | M-2   |
|------------------------------------|---|-------|-------|-------|
| 1. Public Land Survey              | T | _____ | _____ | _____ |
|                                    | T | _____ | _____ | _____ |
|                                    | T | _____ | _____ | _____ |
|                                    | T | _____ | _____ | _____ |
| 2. Property Controlling in Section | S | _____ | _____ | _____ |
|                                    | S | _____ | _____ | _____ |
| 3. Miscellaneous Property in Sec.  | S | _____ | _____ | _____ |
|                                    | S | _____ | _____ | _____ |

Register of Deeds Stamp & File Number

- 4. Lot No. \_\_\_\_\_, Recorded Plat \_\_\_\_\_
- 5. Private Claims \_\_\_\_\_

|    | A  | B  | C  | D  | E  | F  | G | H | I | J | K | L | M |
|----|----|----|----|----|----|----|---|---|---|---|---|---|---|
| 2  | 6  | 5  | 4  | 3  | 2  | 1  |   |   |   |   |   |   |   |
| 3  |    |    |    |    |    |    |   |   |   |   |   |   |   |
| 4  | 7  | 8  | 9  | 10 | 11 | 12 |   |   |   |   |   |   |   |
| 5  |    |    |    |    |    |    |   |   |   |   |   |   |   |
| 6  | 18 | 17 | 16 | 15 | 14 | 13 |   |   |   |   |   |   |   |
| 7  |    |    |    |    |    |    |   |   |   |   |   |   |   |
| 8  | 19 | 20 | 21 | 22 | 23 | 24 |   |   |   |   |   |   |   |
| 9  |    |    |    |    |    |    |   |   |   |   |   |   |   |
| 10 | 30 | 29 | 28 | 27 | 26 | 25 |   |   |   |   |   |   |   |
| 11 |    |    |    |    |    |    |   |   |   |   |   |   |   |
| 12 | 31 | 32 | 33 | 34 | 35 | 36 |   |   |   |   |   |   |   |
| 13 |    |    |    |    |    |    |   |   |   |   |   |   |   |

I, CRAIG J. PULLEN, in a field survey on OCTOBER 23, 1995, do hereby certify that under requirements of P.A. 74, Michigan P.A. of 1970, the corner points mentioned in lines 1 and 2 above were in conformance with regulations and rules therefore as required in the current manual of survey instructions of the United States Department of the Interior, Bureau of Land Management or by a decree of a Court of Law and/or that the corner points mentioned in lines 3, 4 and 5 above were in conformance with the rules of the Michigan Board of Land Surveyors or by a Decree of a Court of Law; established, re-established, monumented, re-monumented, recovered, found as expressed below:

**NOTE: Not more than 4 corners, all in the same town and range, may be recorded on this certificate.**

A. Description of original monument and accessories and/or subsequent restoration:

- M-2 1837 ORIGINAL GOV'T SURVEY BY J. BRINK WOOD POST HEM 10 S36W 35 IRONWOOD 7 N35W 25
- 1902 H. DEVOE SURVEY IN SEC.6, T21N, R10W FOUND LARGE HEMLOCK ABOUT 30 IN. IN DIAMETER TO SW WHICH WAS GOV. WIT. AS COULD SEE PART OF ORIGINAL MARK. HOWEVER IT WAS MUCH LARGER THAN NOTES CALLED FOR. COULD NOT FIND IRONWOOD TO NW AS IT CAME IN ROAD BED. PUT POST IN FROM WITNESS HEM 10 S36W 35
- 1903 D.E. TEED SURVEY IN SEC.1, T21N, R11W ELM 10 S56¼E 46 SUGAR 12 S82¾W 36½
- 1986 J.L. WILCOX, PS #14120 L.C.R.C. L.3, P.408 SET ½" IRON & CAP IN CENTERLINE OF N-S ROAD AND ON LINE WITH FENCES EAST AND WEST. THIS POSITION ALSO FITS OCCUPIED 1/8TH LINE OCCUPATION IN ALL DIRECTIONS. EAST P.POLE 124.47' N52°E WOOD GATE POST 38.09' S85°W P.POLE 34.52' S65°W 12" SPRUCE 40.38'

B. Description of corner evidence found and/or method applied in restoring or reestablishing corner:



- M-2 FOUND ½" IRON IN LINE WITH EAST-WEST ¼ LINE FENCES AND CENTERLINE 25 ROAD AND 4 PREVIOUS WITNESSES. REPLACED WITH 5/8" X 36" IRON AND BRASS CAP. THIS CORNER IS ACCEPTED AS A CAREFUL AND FAITHFUL REESTABLISHMENT OF THE POSITION OF THE ORIGINAL CORNER.

Peer Group Reviewed and Approved

Date: 10 Nov 95  
*Richard D. Wilcox*  
Richard D. Wilcox, Wexford County Surveyor

C. Description of monument for corner and accessories established to perpetuate locating the position of the corner:

- M-2 ¼ CORNER COMMON TO SECTION 1, T21N, R11W, AND SECTION 6, T21N, R10W
- 5/8" X 36" IRON AND BRASS CAP STAMPED: CJP, 39095, 1/4, 6, 1995
- S85°W POWER POLE 34.52'
- S65°W 12" SPRUCE 40.83'
- EAST POWER POLE 124.47'
- N52°E WOOD FENCE POST 38.06'

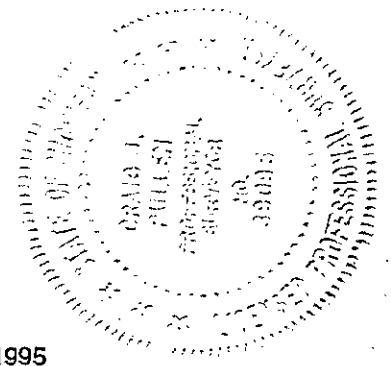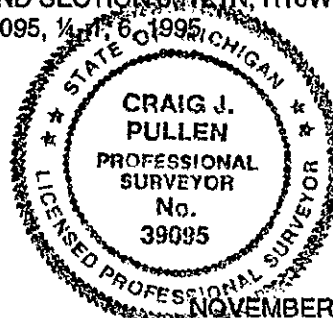

Signed by Craig J. Pullen  
Surveyor's Michigan License No. 39095

Date NOVEMBER 9, 1995