

JAN 17 1996

LAND CORNER RECORDATION CERTIFICATE
Filing Requirement of Act 74, Mich. P.A. 1970

RECEIVED

1995 NOV 13 PM 4: 27

For corners in **COMMISSION**
WEXFORD

Linda Loughmiller
WEXFORD COUNTY, MI
REGISTER OF DEEDS

| | | |
|---------------------------------------|-------------------------|---------------|
| (County) | Located in: | Corner Code # |
| | T 21N R 11W | M-5 |
| 1. Public Land Survey | T _____ R _____ | _____ |
| | T _____ R _____ | _____ |
| | T _____ R _____ | _____ |
| | T _____ R _____ | _____ |
| 2. Property Controlling in Section | S _____ T _____ R _____ | _____ |
| | S _____ T _____ R _____ | _____ |
| 3. Miscellaneous Property in Sec. | S _____ T _____ R _____ | _____ |
| | S _____ T _____ R _____ | _____ |
| 4. Lot No. _____, Recorded Plat _____ | | |
| 5. Private Claims _____ | | |

Register of Deeds Stamp & File Number

| | | | | | | | | | | | | | |
|----|----|----|----|----|----|----|---|---|---|---|---|---|---|
| | A | B | C | D | E | F | G | H | I | J | K | L | M |
| 2 | 6 | 5 | 4 | 3 | 2 | 1 | | | | | | | |
| 3 | | | | | | | | | | | | | |
| 4 | 7 | 8 | 9 | 10 | 11 | 12 | | | | | | | |
| 5 | | | | | | | | | | | | | |
| 6 | 18 | 17 | 16 | 15 | 14 | 13 | | | | | | | |
| 7 | | | | | | | | | | | | | |
| 8 | 19 | 20 | 21 | 22 | 23 | 24 | | | | | | | |
| 9 | | | | | | | | | | | | | |
| 10 | 30 | 29 | 28 | 27 | 26 | 25 | | | | | | | |
| 11 | | | | | | | | | | | | | |
| 12 | 31 | 32 | 33 | 34 | 35 | 36 | | | | | | | |
| 13 | | | | | | | | | | | | | |

I, **CRAIG J. PULLEN**, in a field survey on **OCTOBER 5**, 19 **95**, do hereby certify that under requirements of P.A. 74, Michigan P.A. of 1970, the corner points mentioned in lines 1 and 2 above were in conformance with regulations and rules therefore as required in the current manual of survey instructions of the United States Department of the Interior, Bureau of Land Management or by a decree of a Court of Law and/or that the corner points mentioned in lines 3, 4 and 5 above were in conformance with the rules of the Michigan Board of Land Surveyors or by a Decree of a Court of Law; established, re-established, monumented, re-monumented, recovered, found as expressed below:

NOTE: Not more than 4 corners, all in the same town and range, may be recorded on this certificate.

A. Description of original monument and accessories and/or subsequent restoration:

- M-5 1837 ORIGINAL GLO SURVEY BY J. BRINK WOOD POST BEECH 13 S33 1/2 W 28 BEECH 14 N53 W 43
- 1902 D.E. TEED SURVEY IN SEC.7, T21N, R10W FOUND 4 GOV. WITS. FENCE POST S28E 65 W.PINE 24 N17 1/2 E 89 HEM 12 N38 W 84
- 1968 MDOT SURVEY FOR M-55 L.C.R.C. L.2, P.870 SET 3/4" PIPE AND MON. BOX 12.9' S OF CENTERLINE M-55 AT 25 RD. SEE 44.13' MAILBOX POST SE 42.25' GUARD POST SW 41.08' GUARD POST. THIS INFORMATION IS ALSO IN THE ROAD COMMISSION WITNESS BOOK.
- 1975 J.L. WILCOX & ASSOC. SURVEY L.1, P.354 AND L.C.R.C. L.2, P.776 BY J.L. WILCOX, PS #14102 FOUND 3/4" PIPE IN MON. BOX WITNESSES SAME AS 1968 MDOT L.C.R.C. L.2, P.870
- 1990 WADE-TRIM/GRANGER SURVEY DATED 10-25-90 BY J. RAY, PS #25869 FOUND PIPE IN MON. BOX S70°E MAILBOX POST 52.33' WEST CENTERLINE OF N-S ROAD 12.00' NORTH CENTERLINE OF M-55 12.3' S25°E STOP SIGN 31.90'
- 1995 MITCHELL & ASSOC. SURVEY L.74, P.237 BY D. GRIER PS #33978 FOUND 3/4" PIPE IN MON. BOX 12± SOUTH OF CENTERLINE M-55 BIRCH 8" S10°E 101.20' P.POLE S28°E 133.20' SIGNPOST S32°W 78.90' FENCE POST N30°E 79.12'

B. Description of corner evidence found and/or method applied in restoring or reestablishing corner:


M-5 FOUND 3/4" PIPE IN MONUMENT BOX 12± S OF CENTERLINE M-55 AND 7± E OF CENTERLINE 25 RD. AND 4 PREVIOUS WITNESSES. REPLACED WITH 5/8" X 36" IRON AND BRASS CAP. THIS CORNER IS ACCEPTED AS A CAREFUL AND FAITHFUL REESTABLISHMENT OF THE POSITION OF THE ORIGINAL CORNER.

Peer Group Reviewed and Approved

Date: 10 Nov 95
Richard D. Wilcox
Richard D. Wilcox, Wexford County Surveyor

C. Description of monument for corner and accessories established to perpetuate locating the position of the corner:

- M-5 SECTION CORNER COMMON TO SECTIONS 12 AND 13, T21N, R11W, AND SECTIONS 7 AND 18, T21N, R10W
5/8" X 36" IRON AND BRASS CAP STAMPED: CJP, 39095, 12, 13, 7, 18, 1995
S10°E 8" WHITE BIRCH 101.00'
S32°W SIGN POST 78.70'
S28°E POWER POLE 133.20'
N30°E FENCE POST 79.12'

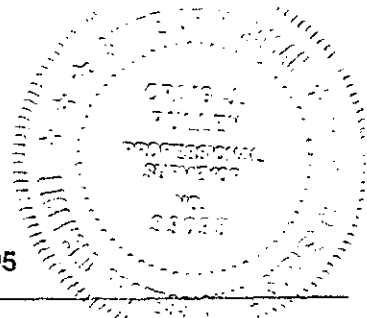

NOVEMBER 9, 1995

Signed by *Craig J. Pullen*
Surveyor's Michigan License No. 39095