

RECEIVED

1995 NOV 13 PM 4: 27

LAND CORNER RECORDATION CERTIFICATE
Filing Requirement of Act 74, Mich. P.A. 1970

JAN 17 1996

Linda Leachmiller
WEXFORD COUNTY, MI
REGISTER OF DEEDS

For corners in
WEXFORD COMMISSION
(County)

Located In: Corner Code #

- 1. Public Land Survey T 21N R 11W M-7
T _____ R _____
T _____ R _____
T _____ R _____
- 2. Property Controlling S _____ T _____ R _____
In Section S _____ T _____ R _____
- 3. Miscellaneous S _____ T _____ R _____
Property in Sec. S _____ T _____ R _____

Register of Deeds Stamp & File Number

- 4. Lot No. _____, Recorded Plat _____
- 5. Private Claims _____

A	B	C	D	E	F	G	H	I	J	K	L	M
2	6	5	4	3	2	1						
3												
4	7	8	9	10	11	12						
5												
6	18	17	16	15	14	13						
7												
8	19	20	21	22	23	24						
9												
10	30	29	28	27	26	25						
11												
12	31	32	33	34	35	36						
13												

I, CRAIG J. PULLEN, in a field survey on OCTOBER 5, 1995, do hereby certify that under requirements of P.A. 74, Michigan P.A. of 1970, the corner points mentioned in lines 1 and 2 above were in conformance with regulations and rules therefore as required in the current manual of survey instructions of the United States Department of the Interior, Bureau of Land Management or by a decree of a Court of Law and/or that the corner points mentioned in lines 3, 4 and 5 above were in conformance with the rules of the Michigan Board of Land Surveyors or by a Decree of a Court of Law; established, re-established, monumented, re-monumented, recovered, found as expressed below:

NOTE: Not more than 4 corners, all in the same town and range, may be recorded on this certificate.

A. Description of original monument and accessories and/or subsequent restoration:

- M-7 1897 ORIGINAL GOV'T SURVEY BY J. BRINK WOOD POST BEECH 11 S48W 31 BEECH 8 N24½W 45
- 1895 A.J. TEED SURVEY IN SEC.24, T21N, R11W FOUND STAKE & 2 GOV'T WITNESSES HEM 30 S55½E 74
- 1902 D.E. TEED SURVEY IN SEC.18, T21N, R10W FOUND STAKE BY A.J. T. WITNESSES HEM 30 S55½E 74 TEL. POLE S64½W 58½
- 1973 WILCOX & ERICKSON SURVEY L.1, P.108 & L.C.R.C. L.2, P.546 BY J. ERICKSON, PS #16929 SET WEXFORD COUNTY MONUMENT IN ROAD INTERSECTION BY SINGLE PROP. DISTANCE ALONG TOWNSHIP LINE N40°E 45.57' FENCE CORNER S50°E 51.13' P.POLE N50°W 74.36' 24" MAPLE
- 1980 & 1985 USFS SURVEYS BY R. GRIFFIN, PS #13584 AND P. LEEMON, PS #31595 RESPECTIVELY. FOUND CORNER AND WITNESSES AS ESTABLISHED BY J. ERICKSON IN 1973 L.C.R.C. L.2, P.546
- 1986 GRANGER ENGINEERING SURVEY L.2, P.334 AND SURVEY BY WADE-TRIM DATED 3-1-95 BY J. RAY, PS #25869 FOUND CO. MON. S50°E P.POLE 51.13' N40°E USFS WIT. POST 45.45' N50°E 24" MAPLE 74.36' S65°W STOP SIGN 45.20'

B. Description of corner evidence found and/or method applied in restoring or reestablishing corner:

M-7 FOUND WEXFORD COUNTY MONUMENT IN POOR CONDITION AND 3 PREVIOUS WITNESSES. REPLACED MONUMENT WITH 5/8" X 36" IRON AND BRASS CAP. THIS CORNER IS ACCEPTED AS A CAREFUL AND FAITHFUL REESTABLISHMENT OF THE POSITION OF THE ORIGINAL CORNER.


Peer Group Reviewed and Approved

Date: 10 Nov 95


Richard D. Wilcox
Richard D. Wilcox, Wexford County Surveyor

C. Description of monument for corner and accessories established to perpetuate locating the position of the corner:

- M-7 SECTION CORNER COMMON TO SECTIONS 18 AND 19, T21N, R10W AND SECTIONS 13 AND 24, T21N, R11W
- 5/8" X 36" IRON WITH BRASS CAP STAMPED: CJP, 39095, 13, 24, 18, 19, 1995
- N50°W 24" TWIN MAPLE 74.72'
- S32°W POWER POLE 84.60'
- S50°E POWER POLE 51.13'
- N40°E CEDAR POST WITH USFS TAG 45.45'

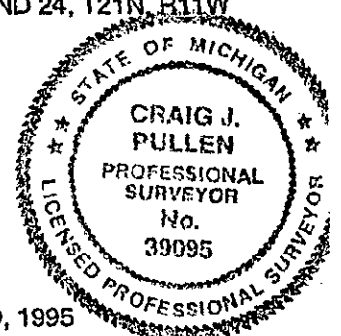

Signed by Craig J. Pullen
Surveyor's Michigan License No. 39095

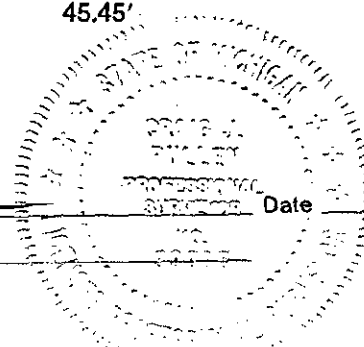

NOVEMBER 9, 1995