

PERPETUATION

RECEIVED

JAN 17 1996

LAND CORNER RECORDATION CERTIFICATE

1995 NOV 13 PM 4: 27

COMMISSION

Filing Requirement of Act 74, Mich. P.A. 1970

For corners in WEXFORD

Linda Doughmiller
WEXFORD COUNTY, MI
REGISTER OF DEEDS

(County)	Located In:	Corner Code #
1. Public Land Survey	T 21N R 11W	M-9
	T _____ R _____	_____
	T _____ R _____	_____
	T _____ R _____	_____
	T _____ R _____	_____
2. Property Controlling in Section	S _____ T _____ R _____	_____
	S _____ T _____ R _____	_____
3. Miscellaneous Property in Sec.	S _____ T _____ R _____	_____
	S _____ T _____ R _____	_____

Register of Deeds Stamp & File Number

4. Lot No. _____, Recorded Plat _____
 5. Private Claims _____

	A	B	C	D	E	F	G	H	I	J	K	L	M
2	6		5		4		3		2		1		
3													
4	7		8		9		10		11		12		
5													
6	18		17		16		15		14		13		
7													
8	19		20		21		22		23		24		
9													
10	30		29		28		27		26		25		
11													
12	31		32		33		34		35		36		
13													

CRAIG J. PULLEN

SEPTEMBER 16

95

I, _____, in a field survey on _____, 19 _____, do hereby certify that under requirements of P.A. 74, Michigan P.A. of 1970, the corner points mentioned in lines 1 and 2 above were in conformance with regulations and rules therefore as required in the current manual of survey instructions of the United States Department of the Interior, Bureau of Land Management or by a decree of a Court of Law and/or that the corner points mentioned in lines 3, 4 and 5 above were in conformance with the rules of the Michigan Board of Land Surveyors or by a Decree of a Court of Law; established, re-established, monumented, re-monumented, recovered, found as expressed below:

NOTE: Not more than 4 corners, all in the same town and range, may be recorded on this certificate.

A. Description of original monument and accessories and/or subsequent restoration:

M-9 1837 GLO SURVEY BY J. BRINK, HEM 12 FOR CORNER TO 24 & 25
 1895 A.J. TEED SURVEY IN SECTION 25, T21N, R11W RESET STAKE FROM GOV. WITS. HEM 24 S14½ E 65
 1970 USFS SURVEY BY R. GRIFFIN, PS #13584 FOUND IRON PIPE AT ROAD INTERSECTION. THE POSITION FITS G.L.O. SWAMP CALL, SO THIS CORNER IS PRESUMED TO BE A RECOVERED CORNER. 5" X 36" MONUMENT W.PINE 3" N46°E 59.15' P.POLE S72°E 111.94' MAPLE 11" S53°W 87.89' MAPLE 16" N66°W 86.59'
 1972 J. ERICKSON, PS #16929, L.C.R.C. L2, P.550 FOUND USFS MONUMENT N45°E 59.51' 3" W. PINE S72°E 122.94' P. POLE S53°W 87.89' 11" MAPLE

B. Description of corner evidence found and/or method applied in restoring or reestablishing corner:


M-9 FOUND USFS MONUMENT WITH TOP BROKEN OFF, AND ALSO FOUND ½" X 18" IRON 0.5' EAST OF CENTER OF MONUMENT. FOUND ALL 3 WITNESSES FROM ERICKSON (1972) AND A 4" X 7' USFS WIT. POST WITH TAG READING - CORNER EAST 32.88'. COULD NOT FIND NAIL IN MAPLE TREE, BUT THE OTHER 2 WITNESSES (WITH USFS TAGS) AND THE POST DISTANCE FIT THE ½" IRON PERFECTLY. DID NOT ACCEPT BROKEN MONUMENT. REPLACED ½" IRON WITH 5/8" X 36" IRON WITH BRASS CAP. THIS CORNER IS ACCEPTED AS A CAREFUL AND FAITHFUL PERPETUATION OF THE POSITION OF THE ORIGINAL CORNER, BEING THE SECTION CORNER COMMON TO SECTIONS 24 AND 25, T21N, R11W, AND SECTIONS 19 AND 30, T21N, R10W.

Peer Group Reviewed and Approved

Date: 10 Nov 95.
Richard D. Wilcox
 Richard D. Wilcox, Wexford County Surveyor

C. Description of monument for corner and accessories established to perpetuate locating the position of the corner:

M-9 SE CORNER, SECTION 24, T21N, R11W
 5/8" X 36" IRON WITH BRASS CAP STAMPED:
 CJP, 39095, 1995, 24, 25, 19, 30
 N46°E 6" WHITE PINE 59.15'
 WEST 4" X 7" POST WITH TAG 32.88'
 S72°E POWER POLE 122.94'
 S44°W 24" MAPLE 87.45'

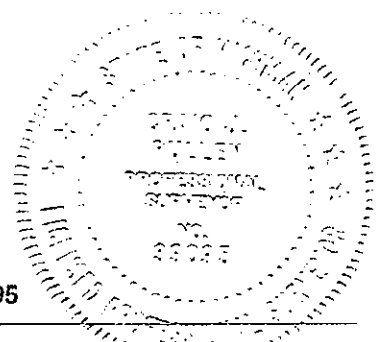

Signed by Craig J. Pullen Date NOVEMBER 9, 1995

Surveyor's Michigan License No. 39095