

RECEIVED

1995 NOV 13 PM 4: 27

JAN 17 1995

LAND CORNER RECORDATION CERTIFICATE

Filing Requirement of Act 74, Mich. P.A. 1970

For corners in WEXFORD

COMMISSION Located In:

Corner Code #

Linda Dougherty
WEXFORD COUNTY, MI
REGISTER OF DEEDS

- 1. Public Land Survey T 21N R 11W M-11
2. Property Controlling in Section S T R
3. Miscellaneous Property in Sec. S T R

Register of Deeds Stamp & File Number

- 4. Lot No. , Recorded Plat
5. Private Claims

Grid with columns A-M and rows 2-13. Cell (11, M) contains a black dot.

I, CRAIG J. PULLEN in a field survey on SEPTEMBER 16, 19 95, do hereby certify that under requirements of P.A. 74, Michigan P.A. of 1970, the corner points mentioned in lines 1 and 2 above were in conformance with regulations and rules therefore as required in the current manual of survey instructions of the United States Department of the Interior, Bureau of Land Management or by a decree of a Court of Law and/or that the corner points mentioned in lines 3, 4 and 5 above were in conformance with the rules of the Michigan Board of Land Surveyors or by a Decree of a Court of Law; established, re-established, monumented, re-monumented, recovered, found as expressed below:

NOTE: Not more than 4 corners, all in the same town and range, may be recorded on this certificate.

A. Description of original monument and accessories and/or subsequent restoration:

- M-11 1837 GLO SURVEY BY J. BRINK, WOOD POST HEM 11 N56 1/2 W 43 HEM 10 S30 1/2 W 30
1895 A.J. TEED SURVEY IN SECTION 25, T21N, R11W CORNER SHOWN AS IN, AND MEASUREMENTS TAKEN FROM IT ARE SHOWN, BUT NO CORNER DESCRIPTION OR WITNESSES GIVEN.
1985 USFS SURVEY BY P. LEEMON, PS #31595, L.C.R.C. L3, P.349 FOUND REMAINS OF GLO STAKE FROM THE GLO WITNESSES 5" X 60" CONCRETE MONUMENT WITH BRASS CAP IRON FENCE POST NORTH 1.7' B. OAK 8" N87°E 43.65' R. PINE 12" S36°E 16.54' R. MAPLE 10" N 33°W 62.34' R. MAPLE 10" 8" S7°E 25.55' B. OAK N69°W 15.89'

B. Description of corner evidence found and/or method applied in restoring or reestablishing corner:


- M-11 FOUND USFS MONUMENT AND ALL 5 WITNESSES FROM 1985. THIS CORNER IS ACCEPTED AS A CAREFUL AND FAITHFUL PERPETUATION OF THE POSITION OF THE ORIGINAL CORNER, BEING THE SECTION CORNER COMMON TO SECTIONS 25 AND 36, T21N, R11W, AND SECTIONS 30 AND 31, T21N, R10W.

Peer Group Reviewed and Approved

Date: 10 Nov 95
Richard D. Wilcox, Wexford County Surveyor

C. Description of monument for corner and accessories established to perpetuate locating the position of the corner:

- M-11 SE CORNER, SECTION 25, T21N, R11W
5" X 60" CONCRETE MONUMENT WITH BRASS CAP NORTH IRON FENCE POST 1.7'
N87°E 10" BLACK OAK 43.65'
S36°E 16" RED PINE 16.54'
N33°W 14" RED MAPLE 62.34'
S7°E 10" RED MAPLE 25.55'
N69°W 12" BLACK OAK 15.89'

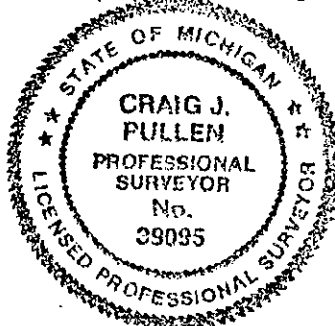

Signed by Craig J. Pullen Date NOVEMBER 9, 1995
Surveyor's Michigan License No. 39095