

MAR 3 1984

COMMISSION

RECEIVED

1993 DEC -2 PM 3:49

LAND CORNER RECORDATION CERTIFICATE
Filing Requirement of Act 74, Mich. P.A. 1970

Linda Loughmiller
WEXFORD COUNTY, MI
REGISTER OF DEEDS

For corners in
WEXFORD
(County)

Located In: _____ Corner Code # _____

- 1. Public Land Survey
T 21N R 12W A-13
T 21N R 12W B-13 ✓
T _____ R _____
T _____ R _____
- 2. Property Controlling in Section
S _____ T _____ R _____
S _____ T _____ R _____
- 3. Miscellaneous Property in Sec.
S _____ T _____ R _____
S _____ T _____ R _____

Register of Deeds Stamp & File Number

4. Lot No. _____, Recorded Plat _____
5. Private Claims _____

	A	B	C	D	E	F	G	H	I	J	K	L	M
2	6	5	4	3	2	1							
3													
4	7	8	9	10	11	12							
5													
6	18	17	16	15	14	13							
7													
8	19	20	21	22	23	24							
9													
10	30	29	28	27	26	25							
11													
12	31	32	33	34	35	36							
13													

CRAIG J. PULLEN in a field survey on OCTOBER 18, 1993

do hereby certify that under requirements of P.A. 74, Michigan P.A. of 1970, the corner points mentioned in lines 1 and 2 above were in conformance with regulations and rules therefore as required in the current manual of survey instructions of the United States Department of the Interior, Bureau of Land Management or by a decree of a Court of Law and/or that the corner points mentioned in lines 3, 4 and 5 above were in conformance with the rules of the Michigan Board of Land Surveyors or by a Decree of a Court of Law; established, re-established, monumented, re-monumented, recovered, found as expressed below:


NOTE: Not more than 4 corners, all in the same town and range, may be recorded on this certificate.

A. Description of original monument and accessories and/or subsequent restoration:

- A-13 1837 GLO SURVEY, WOOD POST B.OAK 16" N14½°E 413 LKS PITCH PINE 4" S10°W 270 LKS
1915 FARGO SURVEY, FOUND WOOD POST. NO U.S. EVIDENCE. NOT USED. NO PIPE SET.
1963 GRIFFIN SURVEY PS #13584, SET 5" X 60" CONCRETE MONUMENT WITH BRASS CAP. B. OAK 7" N10°E 5.45' W.OAK 5" N50°E 141.40' B.OAK 6" N40°W 63.65' COR. FENCE POST N67°E 165.80'
- B-13 1837 GLO SURVEY BY J. BRINK, WOOD POST PITCH PINE 8" N39½°E 8 LKS. PITCH PINE 8" N74½°W 47 LKS.
1973 SURVEY BY GRIFFIN #13584, CORNER RECORDED IN L.1, P.382. SET 5" X 36" CONCRETE MONUMENT WITH BRASS CAP AT PRORATED DISTANCE ON STRAIGHT LINE BETWEEN SOUTHWEST 31 AND SOUTHEAST 31, T21N, R12W 5" W. OAK N8°E 63.88' 5" W. OAK N59°E 89.02' 6" W. OAK N60°W 121.82' 6" X 7' CEDAR POST NORTH 33'

B. Description of corner evidence found and/or method applied in restoring or reestablishing corner:

- A-13 FOUND 5" X 60" CONCRETE MONUMENT WITH BRASS CAP BY GRIFFIN AND 3 OF 4 GRIFFIN WITNESSES INTACT. THIS CORNER IS ACCEPTED AS A CAREFUL AND FAITHFUL PERPETUATION OF THE POSITION OF THE ORIGINAL CORNER.
- B-13 FOUND 5" X 36" CONCRETE MONUMENT WITH BRASS CAP BY GRIFFIN AND WITNESSES FROM L.1, P.382, INTACT.

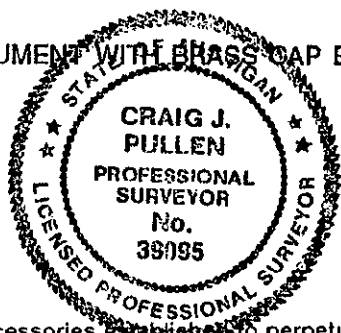

Peer Group Reviewed and Approved

Date: Nov 29 1993
Richard D. Wilcox
Richard D. Wilcox, Wexford County Surveyor

C. Description of monument for corner and accessories established to perpetuate locating the position of the corner:

- | | |
|--|---|
| <ul style="list-style-type: none"> A-13 SW COR. SEC.31, T21N, R12W
FOUND 5" X 60" CONC. MON. WITH U.S.F.S. BRASS CAP
N10°E 12" BLACK OAK 5.45'
N50°E 8" WHITE OAK 141.40'
N42°W 12" BLACK OAK 63.65'
NORTH 6" X 6" CEDAR POST 2.70'
S22°W 6" BLACK OAK 32.94' | <ul style="list-style-type: none"> B-13 S¼ COR. SEC.31, T21N, R12W
FOUND 5" X 36" CONC. MON. W/U.S.F.S. BRASS CAP
16' S OF CENTERLINE ROAD
N8°E 6" WHITE OAK 63.80'
N59°E 8" WHITE OAK 89.02'
N64°W 8" WHITE OAK 121.82'
S7°E 12" WHITE OAK 19.65'
NORTH CEDAR POST 33.00' |
|--|---|

Signed by Craig J. Pullen Date NOVEMBER 23, 1993
Surveyor's Michigan License No. 39095