

MAR 8 1994

RECEIVED

LAND CORNER RECORDATION CERTIFICATE 1993 DEC -2 PM 3:49
Filing Requirement of Act 74, Mich. P.A. 1970

For corners in WEXFORD
(County)

Located In: Corner Code #

Linda Doughmiller
WEXFORD COUNTY, MI
REGISTER OF DEEDS

1. Public Land Survey	T	<u>21N</u>	R	<u>12W</u>	<u>C-13</u>
	T		R		
	T		R		
	T		R		
2. Property Controlling in Section	S		T	R	
	S		T	R	
3. Miscellaneous Property in Sec.	S		T	R	
	S		T	R	

Register of Deeds Stamp & File Number

4. Lot No. _____, Recorded Plat _____
5. Private Claims _____

A	B	C	D	E	F	G	H	I	J	K	L	M
2	6	5	4	3	2	1						
3												
4	7	8	9	10	11	12						
5												
6	18	17	16	15	14	13						
7												
8	19	20	21	22	23	24						
9												
10	30	29	28	27	26	25						
11												
12	31	32	33	34	35	36						
13												

CRAIG J. PULLEN in a field survey on OCTOBER 18, 1993

do hereby certify that under requirements of P.A. 74, Michigan P.A. of 1970, the corner points mentioned in lines 1 and 2 above were in conformance with regulations and rules therefore as required in the current manual of survey instructions of the United States Department of the Interior, Bureau of Land Management or by a decree of a Court of Law and/or that the corner points mentioned in lines 3, 4 and 5 above were in conformance with the rules of the Michigan Board of Land Surveyors or by a Decree of a Court of Law; established, re-established, monumented, re-monumented, recovered, found as expressed below:

NOTE: Not more than 4 corners, all in the same town and range, may be recorded on this certificate.

A. Description of original monument and accessories and/or subsequent restoration:

- C-13 1837 GLO SURVEY BY J. BRINK, WOOD POST PITCH PINE 8" S15°W 40 LKS Y.PINE 14" N87½°W 393 LKS
- 1933 M.S.H.D. SURVEY OF M-37, 1" FLANGED AXLE BENT SPIKE IN POPLAR 12" N60°W 107.9' BENT SPIKE IN POPLAR 8" N56°E 89.9' BENT SPIKE IN OAK 6" S55°E 158.5' BENT SPIKE IN POPLAR 4" S54°W 66.1'
- 1935 U.S. PUBLIC WORKS HIGHWAY PROJECT, 1" IRON AXLE BENT SPIKE IN OAK 14" N56°W 77.6' BENT SPIKE IN J. PINE 5" N60°E 67.5' BENT SPIKE IN T.OAK 6" S85°E 59.8' BENT SPIKE IN OAK 8" S22°W 22.0'
- 1944 M.S.H.D; 3/4" IRON J. PINE 8" N59°E 67.95' OAK 6" S56°E 97.38' OAK 14" N59° W 78.28'
- 1966 SURVEY BY GRIFFIN PS#13584, COR. RECORDED IN L.3, P.337, REPLACED 3/4" IRON WITH 5" SQUARE CONC. POST 3' IN LENGTH 1' BELOW SURFACE. TOP CENTER OF CONC. RIGHT-OF-WAY POST S19°E 207.49' 10" DOCK SPIKE IN W. OAK 6" N73°E 150.65' TOP CENTER OF A 5" CONC. RIGHT-OF-WAY POST S53°E 56.73' TOP CENTER OF TRIANGLE CONC. PROJECT MARKER S73°W 47.94' CENTER OF BLACK OAK N56°W 78.25' 4" X 7' TREATED PINE POST N45°W 105.75' 10" DOCK SPIKE IN W. OAK 7" N26°W 244.61' TOP CENTER RIGHT-OF-WAY POST (CONC.) S77°W 182.05'
- 1973 SURVEY BY WILCOX PS #14102, COR. RECORDED IN L.1, P.272, FOUND SPIKE ABOVE IRON IN CENTERLINE OF M-37 IN LINE WITH E-W GRAVEL ROAD N73°E 150.66' 6" OAK S45°E 56.73' TOP CENTER RIGHT-OF-WAY MARKER S85°W 47.86' CHISELED "X" IN TOP CENTER OF PROJECT MARKER N55°W 78.25' 26" OAK


B. Description of corner evidence found and/or method applied in restoring or reestablishing corner:

- C-13 FOUND 5" CONC. MONUMENT WITH BRASS CAP IN MONUMENT BOX IN CENTERLINE OF M-37 AND WITNESSES FROM L.1, P.272 AND L.3, P.337 INTACT.

Peer Group Reviewed and Approved
Date: 11-29-93
Richard D. Wilcox
Richard D. Wilcox, Wexford County Surveyor

C. Description of monument for corner and accessories established to perpetuate locating the position of the corner:

- C-13 SE CORNER OF SECTION 31, T21N, R12W
- 5" CONCRETE MONUMENT WITH U.S.F.S. BRASS CAP IN MONUMENT BOX
- S19°E TOP CENTER OF CONCRETE RIGHT-OF-WAY MARKER 207.49'
- N68°E 10" W. OAK 150.65'
- S53°E TOP CENTER RIGHT-OF-WAY MARKER 56.73'
- S71°W TOP CENTER CONCRETE PROJECT MARKER 47.94'
- N56°W 36" B. OAK IN CLEAR VISION 78.25'
- N45°W 4" X 4" PINE POST FOR CORNER I.D. 105.75'
- N28°W 10" W. OAK 244.61'
- S77°W TOP CENTER CONCRETE RIGHT-OF-WAY MARKER 182.05'

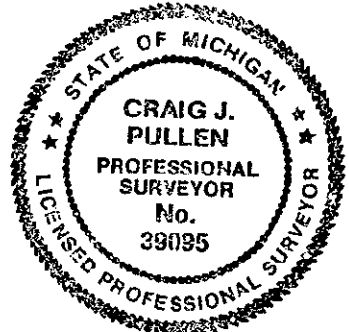

Signed by Craig J. Pullen Date NOVEMBER 3, 1993

Surveyor's Michigan License No. 39095