

SURVEY & RE-ESTABLISHMENT IRON

MAR 3 1 1994

LAND CORNER RECORDATION CERTIFICATE
Filing Requirement of Act 74, Mich. P.A. 1970

RECEIVED

1993 DEC -2 PM 3: 50

For corners in WEXFORD COUNTY COMMISSION (County)

Located In: Corner Code ##

Linda Loughmiller WEXFORD COUNTY, MI REGISTER OF DEEDS

- 1. Public Land Survey T 21N R 12W G-13 J-13
2. Property Controlling in Section S T R
3. Miscellaneous Property in Sec. S T R
4. Lot No. , Recorded Plat
5. Private Claims

Register of Deeds Stamp & File Number

Grid table with columns A-M and rows 2-13. Contains numbers 1-36 and two dots in row 13.

I, CRAIG J. PULLEN, in a field survey on OCTOBER 20, 1993, do hereby certify that under requirements of P.A. 74, Michigan P.A. of 1970, the corner points mentioned in lines 1 and 2 above were in conformance with regulations and rules therefore as required in the current manual of survey instructions of the United States Department of the Interior, Bureau of Land Management or by a decree of a Court of Law and/or that the corner points mentioned in lines 3, 4 and 5 above were in conformance with the rules of the Michigan Board of Land Surveyors or by a Decree of a Court of Law; established, re-established, monumented, re-monumented, recovered, found as expressed below:

NOTE: Not more than 4 corners, all in the same town and range, may be recorded on this certificate.

A. Description of original monument and accessories and/or subsequent restoration:

- G-13 1837 GLO SURVEY BY J. BRINK, WOOD POST PITCH PINE 10" S84°E 680 L. 1968 G. BLASS #5489 SURVEY, 3/4" IRON 1969 R. GRIFFIN #13584 SURVEY, FOUND 3/4" IRON BY BLASS. W. OAK 6" N55°E 114.63' B.OAK 7" N20°W 55.34' POST NORTH 1.50'
J-13 1837 GLO SURVEY BY J. BRINK, WOOD POST BEECH 10" N24°W 10 L. DO. N50°E 30 L. 1968 G. BLASS SURVEY, SURVEY IRON W.OAK 4" N38°E 50.64' B.OAK CLUMP 6" S35°E 69.85' MAPLE 12" S69°W 132.38'

B. Description of corner evidence found and/or method applied in restoring or reestablishing corner:


- G-13 FOUND 3/4" IRON AND GRIFFIN'S WITNESSES INTACT AND REPLACED 3/4" IRON WITH 5/8" X 36" IRON WITH BRASS CAP. THIS CORNER IS ACCEPTED AS A CAREFUL AND FAITHFUL PERPETUATION OF THE POSITION OF THE ORIGINAL CORNER.
J-13 FOUND "T" IRON AND 2 G. BLASS WITNESSES INTACT AND SET 5/8" X 36" IRON WITH BRASS CAP IN "T" IRON POSITION, LEFT "T" IRON ADJACENT TO NEW IRON. THIS CORNER IS ACCEPTED AS A CAREFUL AND FAITHFUL PERPETUATION OF THE POSITION OF THE ORIGINAL CORNER.

Peer Group Reviewed and Approved

Date: Nov. 29, 1993 Richard D. Wilcox, Wexford County Surveyor

C. Description of monument for corner and accessories established to perpetuate locating the position of the corner:

- G-13 SE CORNER, SEC.33, T21N, R12W SET 5/8" X 36" IRON WITH WEXFORD CO. BRASS CAP STAMPED: SC, 33, 34, CJP 39095, 1993 N23°W 12" BLACK OAK 55.34' N55°E 12" WHITE OAK 114.63' NORTH I.D. POST 1.50' S47°W 18" TWIN BLACK OAK 62.68'
J-13 S 1/4 CORNER, SEC.35, T21N, R12W SET 5/8" X 36" IRON WITH WEXFORD CO. BRASS CAP STAMPED: S 1/4, 35, CJP 39095, 1993 S50°E 6" SUGAR MAPLE 24.21' N30°E 8" WHITE OAK 50.90' S67°W 18" SUGAR MAPLE 132.38' N40°W 4" BEECH 10.68'

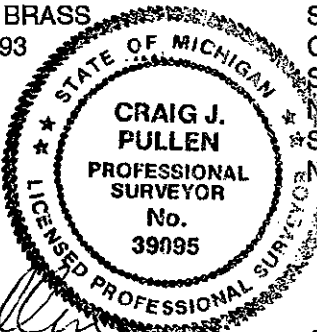

Signed by Craig J. Pullen Date NOVEMBER 23, 1993

Surveyor's Michigan License No. 39095