

SURVEY & REMONUMENTATION

FEB 11 1998

LAND CORNER RECORDATION CERTIFICATE Filing Requirement of Act 74, Mich. P.A. 1970

SECTION

For corners in

Wexford

(County)

Located In:

Corner Code #

- | | | |
|------------------------------------|-----------------------------|-------|
| 1. Public Land Survey | T <u>21</u> N R <u>12</u> W | M-5 |
| | T ___ R ___ | _____ |
| | T ___ R ___ | _____ |
| | T ___ R ___ | _____ |
| 2. Property Controlling in Section | S ___ T ___ R ___ | _____ |
| | S ___ T ___ R ___ | _____ |
| 3. Miscellaneous Property in Sec. | S ___ T ___ R ___ | _____ |
| | S ___ T ___ R ___ | _____ |

RECEIVED

1997 DEC 11 AM 9:30

Linda Loughmiller
WEXFORD COUNTY, MI
REGISTER OF DEEDS

Register of Deeds Stamp & File Number

4. Lot No. _____, Recorded Plat _____
5. Private Claims _____

I, George Smith, in a field survey on July 7, 1997 do hereby state that under requirements of P.A. 74, Michigan P.A. of 1970, the corner points mentioned in lines 1 and 2 above were in conformance with regulations and rules therefore as required in the current manual of survey instructions of the United States Department of the Interior, Bureau of Land Management or by a decree of a Court of Law and /or that the corner points mentioned in lines 3, 4 and 5 above were in conformance with the rules of the Michigan Board of Land Surveyors or by a Decree of a Court of Law, established, re-established, monumented, recovered, found as expressed below.

NOTE: Not more than 2 corners, all in the same town and range, may be recorded on this certificate.

	A	B	C	D	E	F	G	H	I	J	K	L	M
1													
2		6		5		4		3		2		1	
3													
4		7		8		9		10		11		12	
5													
6		18		17		16		15		14		13	
7													
8		19		20		21		22		23		24	
9													
10		30		29		28		27		26		25	
11													
12		31		32		33		34		35		36	
13													

A. Description of original monument and accessories and/or subsequent restoration:

- M-5) 1837 GLO Section Post by John Brink, Deputy Surveyor; Sugar 8 S61½°W42; Beech 16 N9°W67
 1906 D. E. Teed found stake and remains of Gov. wit. Sugar 16 S74° W45L, Sugar 18, N63°W50
 1914 Survey Notes by C.E. Sawyer Fargo Eng. Co. found stake, no witnesses taken
 1973 Griffin RLS #13584 LCRC (field survey in 1966), Liber 1, Page 376. Found rotted wood stake and 1"x24" iron pipe in line with road north loc. checks well with known corners north and is presumed to be the "stake" found by C.E. Sawyer in 1914 and that the 1"x24" pipe was driven through center of wood stake, replaced pipe with 6"x5" conc. post with 3" brass disk. Stamped T21N. R12W, R11W, S12, S7, S13, S18, 1965 Maple 5" S46°E 19.93' set 10" dock spike Maple 3" S19°W 22.87' set 10" dock spike Ash 5' N32°W 17.89' set 10" dock spike Centerline M-55 North 154.7'

B. Description of corner evidence found and/or method applied in restoring or reestablishing corner:

- (A continued) 19?? WCRC witnesses same as Griffin's LCRC
 1975 J.L. Wilcox RLS #14102 LCR Liber 2, Page 805, Found USFS mon., witnesses same as 1973 Griffin's LCRC.

B.) Found USFS mon. and 3 witnesses from Griffin's LCRC this corner is accepted as the best available evidence of the position of the original corner, being the section common to sections 12 and 13, T21N-R12W and Sections 7 and 18, T21N-R11W


C. Description of monument for corner and accessories established to perpetuate locating the position of the corner:

USFS mon. with 3" brass disk stamped T21N, R12W, R11W, S12, S13, S18, S7, 1965 RLS #13584
 S46°E 20.00' Found nail in 6" Maple
 S19°W 22.93' Found nail in 6" Maple
 N32°W 17.85' Found nail in 10" Ash
 N708W 21.30' 4" Maple

Peer Group Reviewed and Approved

Date: 10-30-97
Richard D. Wilcox
 Richard D. Wilcox, Wexford County Surveyor

Signed by _____
 Surveyor's Michigan License No. _____

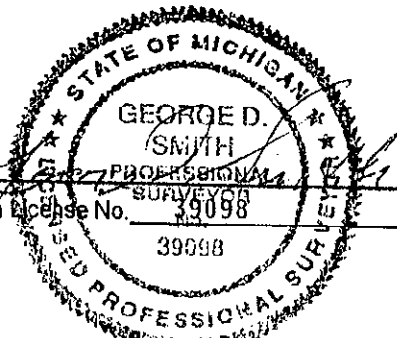

Date 10-30-97