

# SURVEY & REMONUMENTATION

FEB 11 1998

## SECTION

## LAND CORNER RECORDATION CERTIFICATE Filing Requirement of Act 74, Mich. P.A. 1970

For corners in

Wexford

(County)

Located In:

Corner Code #

- |                                    |                            |       |
|------------------------------------|----------------------------|-------|
| 1. Public Land Survey              | T <u>21</u> NR <u>12</u> W | M-6   |
|                                    | T ___ R ___                | _____ |
|                                    | T ___ R ___                | _____ |
|                                    | T ___ R ___                | _____ |
| 2. Property Controlling in Section | S ___ T ___ R ___          | _____ |
|                                    | S ___ T ___ R ___          | _____ |
| 3. Miscellaneous Property in Sec.  | S ___ T ___ R ___          | _____ |
|                                    | S ___ T ___ R ___          | _____ |

RECEIVED

1997 DEC 11 AM 9:31

*Linda Loughmiller*  
WEXFORD COUNTY, MI  
REGISTER OF DEEDS

Register of Deeds Stamp & File Number

4. Lot No. \_\_\_\_\_, Recorded Plat \_\_\_\_\_  
5. Private Claims \_\_\_\_\_

I, George D. Smith, in a field survey on 9-25, 1997 do hereby state that under requirements of P.A. 74, Michigan P.A. of 1970, the corner points mentioned in lines 1 and 2 above were in conformance with regulations and rules therefore as required in the current manual of survey instructions of the United States Department of the Interior, Bureau of Land Management or by a decree of a Court of Law and /or that the corner points mentioned in lines 3, 4 and 5 above were in conformance with the rules of the Michigan Board of Land Surveyors or by a Decree of a Court of Law, established, re-established, monumented, recovered, found as expressed below:

NOTE: Not more than 2 corners, all in the same town and range, may be recorded on this certificate.

	A	B	C	D	E	F	G	H	I	J	K	L	M
1													
2	6		5		4		3		2		1		
3													
4	7		8		9		10		11		12		
5													
6	18		17		16		15		14		13		
7													
8	19		20		21		22		23		24		
9													
10	30		29		28		27		26		25		
11													
12	31		32		33		34		35		36		
13													

A. Description of original monument and accessories and/or subsequent restoration:

- M-6) 1837 GLO 1/4 Section Post by John Brink, Deputy Surveyor; W. Pine 9 S57°W31; W. Pine 8 N57°W 18
- 1906 D. E. Teed Survey, Liber 1, Page 95, Bottle and Stone, W. Pine 14 N34½°W 44, W. Pine 14 N 83½° W 83½, distance to Northeast corner 2658.48', distance to Southeast corner 2635.38'
- 1920 Frank McClung Survey for road improvements, corner found and indicates corner is in centerline of road, Pine SW 29', F.P. East 32, Pine SW 32', distance to Southeast corner 2635.50'
- 19?? WCRC witnesses, no description given, Cherry S28°E 62.70', T.P. S18°E 105.70'

B. Description of corner evidence found and/or method applied in restoring or reestablishing corner:

Re-established corner based on prorations to D.E. Teed's 1906 Survey, by holding prorated distance of 2635.81 (Teed 2635.38, McClung 2635.5) and projecting thru witness pull for Teed's 1/8th corner position falls in centerline road extended North, this position agrees with 1920 McClung position. Road now P's to East, and pines have been cut and area plowed within 100' on West side road, destroying old witnesses.

At corner position we dug large hole ±4' deep in search of bottle and stone but could not locate. This position of corner is accepted as a careful and faithful re-establishment of the position of the original corner being the 1/4 corner common to Section 13, T21N-R12W and Section 18, T21N-R11W.

C. Description of monument for corner and accessories established to perpetuate locating the position of the corner:

Set 5/8" x 36" iron with Wexford County brass cap stamped, 1997, E 1/4 13 39098, opposite fence line to East and 1' West of West edge of asphalt.


- S52°W 35.87' Phone Riser Post
- S42°E 70.81' 12" W. Pine
- N82°W 66.52' 12" R. Pine
- N53°W 65.90' 12" R. Pine

Peer Group Reviewed and Approved

Date: 30 Oct 97

*Richard D. Wilcox*  
Richard D. Wilcox, Wexford County Surveyor

Signed by George D. Smith  
Surveyor's Michigan License No. 39098

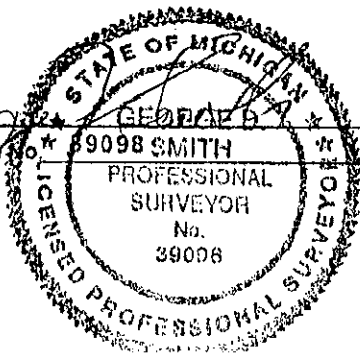

Date 10-30-97