SURVEY & REMONUMENTATION

FEB 11 1998

# LAND CORNER RECORDATION CERTIFICATE

**Filing Requirement of Act 74, Mich. P.A. 1970**

RECEIVED

1997 DEC 11 AM 9:31

Linda Loughmiller
WEXFORD COUNTY, MI
REGISTER OF DEEDS

**Register of Deeds Stamp & File Number**

For corners in SECTION Wexford (County) Located In: Corner Code #

1. Public Land Survey T 21N R 12W M-8
   T ____ R ____
   T ____ R ____
   T ____ R ____
2. Property Controlling S ____ T ____ R ____
   in Section S ____ T ____ R ____
3. Miscellaneous S ____ T ____ R ____
   Property in Section S ____ T ____ R ____

4. Lot No. _____, Recorded Plat _____
5. Private Claims _____

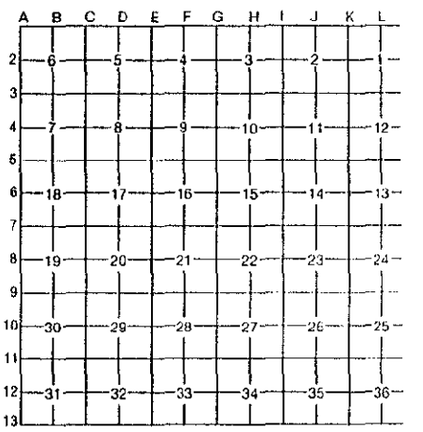


I, George Smith, in a field survey on July 7, 19 97, do hereby certify that under requirements of P.A. 74, Michigan P.A. of 1970, the corner points mentioned in lines 1 and 2 above were in conformance with regulations and rules therefore as required in the current manual of survey instructions of the United States Department of the Interior, Bureau of Land Management or by a decree of a Court of Law and/or that the corner points mentioned in lines 3, 4 and 5 above were in conformance with the rules of the Michigan Board of Professional Surveyors or by a Decree of a Court of Law; established, re-established, monumented, re-monumented, recovered, found as expressed below:

**NOTE: Not more than 4 corners, all in the same town and range, may be recorded on this certificate.**

**A. Description of original monument and accessories and/or subsequent restoration:**

M-8) 1837 GLO¼ Section Post by John Brink, Deputy Surveyor; Birch 10 S58½°W 21, Sugar 8 N57½° W 07
19 ?? W.C.R.C. witnesses, Cherry S28°E 62.70 old wit book, TP S10°E 105.70'
1981 J.L. Wilcox RLS #14102 LCRC, Liber 3, Page 255, set ½ iron with cap by single proportion iron is 2.4' West of centerline black top and 27'± North of post row to West, S60°W 43.01', Fence Post N70°W 57.69', 8" Red Pine N 80°E 88.17', 10" Red Pine S58°E 108.85', 12" Red Pine

**B. Description of corner evidence found and/or method applied in restoring or reestablishing corner:**

Found 1/2" I & C #14102 ± 1.2' W'ly of centerline 13 road and ± 15' N'ly 2-track to W. Replaced 1/2" iron with 5/8"x36" iron with Wexford brass cap stamped E¼ 24, 1997 PS #39098. This corner is accepted as a careful and faithful re-establishment of the position of the original corner being the quarter corner common to Sec 24,T21N-R12W and Sec 19,T21N-R11W.

**C. Description of monument for corner and accessories established to perpetuate locating the position of the corner:**

5/8"x3/6" iron with Wex. Co. brass cap in mon box ±1.2' W'ly of centerline 13 road.
N85°W 56.81' Found spk. in 14" R. Pine
N75°E 88.27' Found spk. in 15" R. Pine
S58°E 108.73' Found spk. in 16" R. Pine
S63°W 65.34' Set nail in 10" R. Pine

Peer Group Reviewed and Approved
Date: 30 Oct 97
Richard D. Wilcox, Wexford County Surveyor

STATE OF MICHIGAN GEORGE D. SMITH PROFESSIONAL SURVEYOR No. 39098 REGISTERED PROFESSIONAL SURVEYOR

Signed by _____ Date 10-30-97

Surveyor's Michigan License No. 39098

FORM APPROVED BY MICHIGAN STATE BOARD OF PROFESSIONAL SURVEYORS, JAN. 28, 1971
REVISED MAY 14, 1975
REVISED JAN., 1983