

SURVEY & REMONUMENTATION

FEB 11 1998

SECTION

LAND CORNER RECORDATION CERTIFICATE Filing Requirement of Act 74, Mich. P.A. 1970

For corners in

Wexford	Located In:	Corner Code #	
(County)			
1. Public Land Survey	T <u>21</u> N R <u>12</u> W	<u>M-9</u>	
	T _____ R _____	_____	
	T _____ R _____	_____	
	T _____ R _____	_____	
2. Property Controlling in Section	S _____ T _____ R _____	_____	
	S _____ T _____ R _____	_____	
3. Miscellaneous Property in Sec.	S _____ T _____ R _____	_____	
	S _____ T _____ R _____	_____	

RECEIVED

1997 DEC 11 AM 9:31

Linda Loughmiller
WEXFORD COUNTY, MI
REGISTER OF DEEDS

Register of Deeds Stamp & File Number

4. Lot No. _____, Recorded Plat _____

5. Private Claims _____

I, George Smith, P.S., in a field survey on July 9, 1997 do hereby state that under requirements of P.A. 74, Michigan P.A. of 1970, the corner points mentioned in lines 1 and 2 above were in conformance with regulations and rules therefore as required in the current manual of survey instructions of the United States Department of the Interior, Bureau of Land Management or by a decree of a Court of Law and /or that the corner points mentioned in lines 3, 4 and 5 above were in conformance with the rules of the Michigan Board of Land Surveyors or by a Decree of a Court of Law; established, re-established, monumented, recovered, found as expressed below:

NOTE: Not more than 2 corners, all in the same town and range, may be recorded on this certificate.

	A	B	C	D	E	F	G	H	I	J	K	L	M
1													
2		6		5		4		3		2		1	
3													
4		7		8		9		10		11		12	
5													
6		18		17		16		15		14		13	
7													
8		19		20		21		22		23		24	
9													
10		30		29		28		27		26		25	
11													
12		31		32		33		34		35		36	
13													

A. Description of original monument and accessories and/or subsequent restoration:

- M-9) 1837 GLO Section Post by John Brink, Deputy Surveyor; Sugar N77 1/2°W 12, White Pine 9 S26°W 16
- 1953 Sageman CE #5156, Survey for W.C.R.C., Monument box, No witnesses given
- 1966 Griffin RLS #13584 LCRC, Liber 1, Page 401, found iron raised to surface with railroad spike at int. paved roads North-West and gravel road to East, replaced with 5" square conc. post 3' in length, 9" R. Pine N 74°E 261.38', North-West corner Church Foundation S51°W 91.48', Top center of Tombstone (John and Elizabeth Vanantwerp) N50°W 68.11', P.P. N 19°W 88.61', 4"x4" Post S45°E 46.70'
- 1974 J. Granger RLS #16041 LCRC, Liber 2, Page 672, found 1" iron rod S45°E 46.7' Cedar post, N19°W 88.61' Telephone pole, N74°E 261.38' 12" Red Pine
- 1979 J. Erickson RLS #16929 LCRC, Liber 3, Page 319, found spike over iron in centerline East-West road N50°W 9" Maple 69.0', N45°E 18" TW Box elder 83.35', S45°W North-West corner Church 92.30'
- 1979 J. Erickson RLS #16929, Certificate of Survey found spike over iron, witnesses same as LCRC, Liber 3, Page 319
- 1990 P. Case RLS #30079 Certificate of Survey, Liber 69, Page 597, found 1" diameter iron rod N45°E South-West corner Banker School House 102.00', S45°E 4"x4" post 46.70', N19°W telephone pole 88.61', N74°E 12" red pine 261.38'

B. Description of corner evidence found and/or method applied in restoring or reestablishing corner:

Found 3/4" iron in centerline road North-South and 2'SLY centerline road East-West, and 1 witness from 1974 J. Granger PS #16041 LCRC. This corner is accepted as the best available evidence of the position of the original corner being the Section corner common to sections 24 and 25 T21N-R12W, and sections 19 and 30 T21N-R11W


C. Description of monument for corner and accessories established to perpetuate locating the position of the corner:

- Replaced 3/4" iron with 5/8"x36" iron with Wexford County brass cap stamped SE24, 1997 PS #39098 in mon box.
- S45°E 46.68' Set nail in 4"x4" post
- N19°W 88.64' Found nail in T.P. (J. Granger witness)
- N25°E 83.88' Found spk in P.P.
- N55°E 82.55' Set spk. in 6" maple

Peer Group Reviewed and Approved

Date: 29 Oct 97
Richard D. Wilcox
Richard D. Wilcox, Wexford County Surveyor

Signed by _____
Surveyor's Michigan License No. _____

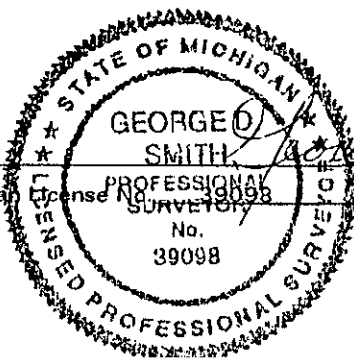

Date 10-30-97