

SURVEY & REMONUMENTATION

FEB 11 1998

SECTION

LAND CORNER RECORDATION CERTIFICATE Filing Requirement of Act 74, Mich. P.A. 1970

For corners in

Wexford	Located In:	Corner Code #	
(County)			
1. Public Land Survey	T <u>21</u> NR <u>12</u> W	M-11	
	T ___ R ___	___	___
	T ___ R ___	___	___
	T ___ R ___	___	___
2. Property Controlling in Section	S ___ T ___ R ___	___	___
	S ___ T ___ R ___	___	___
3. Miscellaneous Property in Sec.	S ___ T ___ R ___	___	___
	S ___ T ___ R ___	___	___

RECEIVED

1997 DEC 11 AM 9:31

Linda Loughmiller
WEXFORD COUNTY, MI
REGISTER OF DEEDS

Register of Deeds Stamp & File Number

4. Lot No. _____, Recorded Plat _____
5. Private Claims _____

I, George D. Smith, in a field survey on July 3, 1997 do hereby state that under requirements of P.A. 74, Michigan P.A. of 1970, the corner points mentioned in lines 1 and 2 above were in conformance with regulations and rules therefore as required in the current manual of survey instructions of the United States Department of the Interior, Bureau of Land Management or by a decree of a Court of Law and/or that the corner points mentioned in lines 3, 4 and 5 above were in conformance with the rules of the Michigan Board of Land Surveyors or by a Decree of a Court of Law, established, re-established, monumented, recovered, found as expressed below:

NOTE: Not more than 2 corners, all in the same town and range, may be recorded on this certificate.

	A	B	C	D	E	F	G	H	I	J	K	L	M
1													
2		6		5		4		3		2		1	
3													
4		7		8		9		10		11		12	
5													
6		10		17		16		15		14		13	
7													
8		19		20		21		22		23		24	
9													
10		30		29		28		27		26		25	
11													
12		31		32		33		34		35		36	
13													

- A. Description of original monument and accessories and/or subsequent restoration:
- M-11) 1837 GLO Section Post by John Brink, Deputy Surveyor, W. Pine 10, S55°W 29, Aspen 11, N 57°W 19
 - 1889 A.J. Teed Survey, Liber 1, Page 103, Corner found no description or witnesses given
 - 1915 Survey notes by George H. Johnson, County Surveyor - Lake County, found iron in road, no description given
 - 1966 Griffin RLS #13584, LCRC Liber 1, Page 402, found wagon skein in East-West Road and with old fence line to South, replaced with 5"x3' conc. mon. with 3" brass disk stamped T21N, R12W, R11W, Section 25, 30, 36, 31, 1966 RLS 13584, 10" Maple N14°E 39.18', 9" TW Red Pine South 42.09', 8" Red Pine S46°W 84.80', 4" Red Pine N36°W 66.29'
 - 19?? W.C.R.C. witnesses same as Griffins

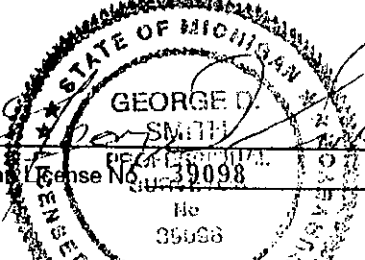
B. Description of corner evidence found and/or method applied in restoring or reestablishing corner:

Found USFS monument with 3" brass disk and 4 witnesses as set by Griffin RLS #13584. This corner is accepted as the best available evidence of the position of the original corner being the Section corner common to Section 25 and 36, T21N-R12W and Sections 30 and 31, T21N, R11W.

C. Description of monument for corner and accessories established to perpetuate locating the position of the corner:

USFS monument with 3" brass disk stamped T21N, R12W, R11W. S25, S30, S36, S31, 1966 RLS #13584
 N14°E 39.28 feet 14" Maple, found nail
 N36°W 66.55 feet 10" Red pine, found nail
 S46°W 84.80 feet 10" Dead red pine, found nail
 South 42.07 feet 12" Red pine, found nail

Peer Group Reviewed and Approved
 Date: 10-30-97
Richard D. Wilcox
 Richard D. Wilcox, Wexford County Surveyor

Signed by _____
 Surveyor's Michigan License No. 39098


Date 10-30-97