

SURVEY & REMONUMENTATION

FEB 11 1998

SECTION

LAND CORNER RECORDATION CERTIFICATE
 Filing Requirement of Act 74, Mich. P.A. 1970

For corners in

<u>Wexford</u> (County)	Located in:	Corner Code #
1. Public Land Survey	T21NR 12W	M-12
	T ___ R ___	_____
	T ___ R ___	_____
	T ___ R ___	_____
2. Property Controlling in Section	S ___ T ___ R ___	_____
	S ___ T ___ R ___	_____
3. Miscellaneous Property in Sec.	S ___ T ___ R ___	_____
	S ___ T ___ R ___	_____

RECEIVED

1997 DEC 11 AM 9:31

Linda Laughmiller
 WEXFORD COUNTY, MI
 REGISTER OF DEEDS

Register of Deeds Stamp & File Number

4. Lot No. _____, Recorded Plat _____
 5. Private Claims _____

I, George Smith, in a field survey on July 3, 1997 do hereby state that under requirements of P.A. 74, Michigan P.A. of 1970, the corner points mentioned in lines 1 and 2 above were in conformance with regulations and rules therefore as required in the current manual of survey instructions of the United States Department of the Interior, Bureau of Land Management or by a decree of a Court of Law and for that the corner points mentioned in lines 3, 4 and 5 above were in conformance with the rules of the Michigan Board of Land Surveyors or by a Decree of a Court of Law, established, re-established, monumented, recovered, found as expressed below:

NOTE: Not more than 2 corners, all in the same town and range, may be recorded on this certificate.

A	B	C	D	E	F	G	H	I	J	K	L	M
1												
2	6	5	4	3	2	1						
3												
4	7	8	9	10	11	12						
5												
6	18	17	16	15	14	13						
7												
8	19	20	21	22	23	24						
9												
10	30	29	28	27	26	25						
11												
12	31	32	33	34	35	36						
13												

A. Description of original monument and accessories and/or subsequent restoration:

- M-12) 1837 GLO Quarter Section Post by John Brink, Deputy Surveyor; W. Pine 10 S63°W 9, Aspen 10 N74°W 19
- 1915 Survey notes by George H. Johnson, Lake County Surveyor, No description of corner given, W. Pine 10 S18½°E 26', W. Pine 12° S10°W 20.5', W. Pine 20° S68½°W 26'
- 1966 Griffin RLS #13584 LCRC, Liber 1, Page 403, found rotted wood stake 236' South of Centerline of old railroad grade and 3 witnesses from 1915 Johnson notes, replaced wood stake with 5"x5' conc. mon. with 3" brass disk stamped: T21N, R12W, R11W, S36, S31, RLS #13584, 30" W.Pine N12°E 88.25', 10" Maple N39°E 49.86', 6" Red Pine S86°E 81.79', 2" Red Pine S72°W 20.40'

B. Description of corner evidence found and/or method applied in restoring or reestablishing corner:


Found USGS monument and 3 witnesses as set by Griffin RLS #13584. This corner is accepted as the best available evidence of the position of the original corner being the quarter corner common to Section 36, T21N-R12W and Section 31, T21N-R11W.

C. Description of monument for corner and accessories established to perpetuate locating the position of the corner:

USFS Monument with 3" brass disk stamped T21N, R12W, R11W, S36, S31, RLS #13584
 N12°E 88.30 feet 38" White pine, found nail
 N39°E 49.69 feet 14" Maple, found nail
 S86°E 81.79 feet 12" Red pine, found nail
 S72°W 20.52 feet 8" Red pine, set nail

Peer Group Reviewed and Approved
 Date: 30 Oct 97
Richard D. Wilcox
 Richard D. Wilcox, Wexford County Surveyor

Signed by *George D. Smith*
 Surveyor's Michigan License No. 39098

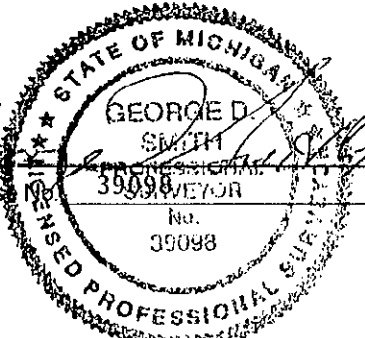

Date 10-30-97