


STATE OF MICHIGAN  
DEPARTMENT  
OF  
NATURAL RESOURCES

LAND CORNER RECORD

WEXFORD COUNTY  
T 22 N R 9 W

DESCRIPTION OF CORNER 1/4 corner common to Sections 35 - 36  
 CORNER MONUMENT Found 3/4" rod. Drove 1"x24" pipe over it. Set Cedar Guard post with location tag.  
 DATE MONUMENT PLACED AND WITNESSED 4-30-71  
 WITNESSES TO CORNER.....

<u>16" Beech</u>	<u>N 18 E</u>	<u>19.38'</u>
<u>20" Oak</u>	<u>N 74 E</u>	<u>85.05'</u>
<u>12" Maple</u>	<u>S 30 W</u>	<u>81.90'</u>

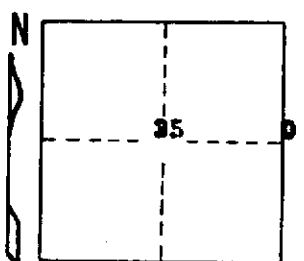

AND

CIRCLE CORNER REGISTERED

DESCRIPTION IN DETAIL AS TO HOW CORNER WAS LOCATED AND IDENTIFIED OR RESTORED.

**This corner, being a 3/4" rod, was recovered by the MSHD in 1966. They recovered the corner from Teed Survey dated May 1903.**

SURVEYOR'S SEAL

SIGNED Carl F. Rosen DATE 5-6-71  
 REGISTERED LAND SURVEYOR 12028

DISTRIBUTION:

County Courthouse  
Area Forester (Regions I & II)  
District or Region Surveyor  
Forestry Div., Lansing