

LAND CORNER RECORDATION CERTIFICATE

FILING REQUIREMENT OF ACT 74, MICH. P.A.1970

FOR CORNERS OF--:	LOCATED IN--:	CORNER CODE NUMBER
1. PUBLIC LAND SURVEY _____	T. <u>22</u> N. <u>9</u> W.	<u>E-4;E-5;F-4</u>
2. PROPERTY CONTROLLING IN SECTION _____	T. _____ N. _____ S. _____ R. _____ E. _____ W. _____	_____
3. MISCELLANEOUS PROPERTY IN SECTION _____	T. _____ N. _____ S. _____ R. _____ E. _____ W. _____	_____
4. LOT NO. _____, RECORDED PLAT _____		
5. PRIVATE CLAIMS _____		

REGISTER OF DEEDS STAMP AND FILING NUMBER

I, Carl F. Roser, do hereby certify that under requirements of P.A. 74, Michigan P.A. of 1970, the corner points mentioned in lines 1 and 2 above were, in a field survey on January 2, 19 86, established, re-established, monumented, re-monumented, recovered or restored as expressed below and in conformance with regulations and rules therefore as required in the current manual of survey instructions of the United States Department of the Interior, Bureau of Land Management or by a decree of a court of law. Furthermore, that the corner points mentioned in lines 3, 4 and 5 above were, in a field survey on _____, 19____, found, recovered, restored, established or re-established as expressed below and in conformance with the rules of the Michigan State Board of Registration for Land Surveyors or, by a Decree of a Court of law:

C. (Continued):

~~100 Description of boundary lines and accessories established to perpetuate locating the position of the corner:~~

F-4

Drove 5/8" x 34" rerod w/RLS cap
set cedar post w/loc tag

3" Red Oak	N40°W	14.3'
3" Red Oak	N55°E	22.4'
3" Red Oak	S85°E	21.4'
Ctr. N-S trail	Due E	6'

B. Description of corner evidence found and/or method applied in restoring or re-establishing corner:

- E-4 - Previous Dept. cor. of record (KJO-1958). KJO had Govt. B.T. remains. Ctr. R.R. track is 240'± E. Ctr. sand trail rd. (approx. parallel w/tracks) is 90'±E.
- E-5 - Fd. & accepted Wex. Co. mon. (broken) for SW cor. of Sec. 9. Dept. mon. (KJO-1958) now gone. Wex. Co. mon. fits 1958 distances to cor.'s. in Sec. 9 ½ MI. N&E. Approx. inter. of gravel rds E-W-S & tr. rd. N. is 7'± east.
- F-4 - Drove 5/8" x 34" rerod for ctr. of Sec. 9 from three 1903 D.E. Teed wits.; Teed had two White Pine Bits. & one Yellow Pine B.T. of which all are now stumps. Recovered ctr. fits within less than two feet for position of calc. intersection of ½ lines.

C. Description of monument for corner and accessories established to perpetuate locating the position of the corner:

<u>E-4</u>	<u>E-5</u>	
Fd. Dept. mon. & cedar post; added new cedar post	Fd. broken Wex. Co. mon.; raised w/1" x 12" pipe w/RLS cap	
12" Maple (clp) South 71.2'	10" Red Pine N20°W 22.45'	
8" Maple (clp) N50°E 31.6'	11" Red Pine S40°W 42.50'	
22" Twin Oak S82°E 37.0'	14" Red Pine N50°E 52.42'	
4" Red Pine S40°E 88.4'	17" Cherry S46°E 92.15'	
	Set cedar post w/loc tag North 33'	

SIGNED BY Carl F. Roser 01-24-86 DATE _____

SURVEYOR'S MICHIGAN REGISTRATION NO. 12028


FOR STATE AND UNITED STATES AGENCIES:

SIGNED BY _____ DATE _____

CHIEF OF SURVEY PARTY

APPROVED AND SIGNED BY _____ DATE _____

MICHIGAN REGISTERED LAND SURVEYOR

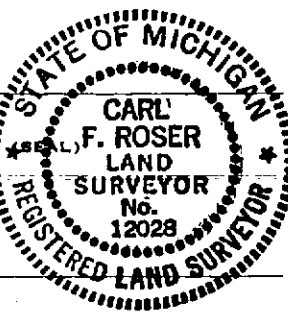

(SEAL)

SURVEYOR'S MICHIGAN REGISTRATION NO. _____

Wexford County