

LAND CORNER RECORDATION CERTIFICATE

FILING REQUIREMENT OF ACT 74, MICH. P.A.1970

FOR CORNERS OF --:	LOCATED IN --:	CORNER CODE NUMBER
1. PUBLIC LAND SURVEY _____	T. <u>22</u> N. <u>9</u> W. <u>9</u>	<u>L-3; L-4; L-5</u>
2. PROPERTY CONTROLLING IN SECTION <u>11</u>	T. <u>22</u> N. <u>9</u> W. <u>9</u>	<u>15</u>
3. MISCELLANEOUS PROPERTY IN SECTION _____	T. _____ N. _____ W. _____	_____
4. LOT NO. _____	RECORDED PLAT _____	_____
5. PRIVATE CLAIMS _____	_____	_____

REGISTER OF DEEDS STAMP AND FILING NUMBER

I, Carl F. Roser, do hereby certify that under requirements of P.A. 74, Michigan P.A. of 1970, the corner points mentioned in lines 1 and 2 above were, in a field survey on January 9, 19 86, established, re-established, monumented, re-monumented, recovered or restored as expressed below and in conformance with regulations and rules therefore as required in the current manual of survey instructions of the United States Department of the Interior, Bureau of Land Management or by a decree of a court of law. Furthermore, that the corner points mentioned in lines 3, 4 and 5 above were, in a field survey on _____, 19____, found, recovered, restored, established or re-established as expressed below and in conformance with the rules of the Michigan State Board of Registration for Land Surveyors or, by a

Decree of a Court of law:

C. (Continued):

<u>L-4</u>	<u>L-5</u>
Drove 5/8" x 34" rerod w/RLS cap & set cedar post w/loc tag	Fd. Dept. mon.; added cedar post
18" White Oak (clp 2) N40°E 17.1'	13" Red Oak N35°W 71.8'
3" Red Oak S25°E 21.8'	16" Red Oak N05°E 32.0'
19" Red Oak S75°W 26.5'	8" Red Oak (clp 4) N80°E 31.1'
Ctr. tr. on ridge Due W 31'	14" Red Oak S60°E 49.3'
	Fd. 1" x 18" pipe S50°E 7.3'

B. Description of corner evidence found and/or method applied in restoring or re-establishing corner:
 15 - Fd. 1" pipe (KJO-1958) for SW corner of SE 1/4 of SW 1/4 of Section 11.

L-3 - Previous Dept. corner of record (KJO-1958).

L-4 - Estab. center of Section 12 at intersection of 1/4 lines.

L-5 - Previous Dept. corner of record (KJO-1958).

C. Description of monument for corner and accessories established to perpetuate locating the position of the corner:

<u>15</u>	<u>L-3</u>
34" Red Oak N25°W 21.9'	Fd. Dept. mon.; added cedar post
14" Red Oak N30°E 58.0'	12" Red Oak N20°E 8.5'
4" Beech S55°E 41.8'	17" Red Oak S40°E 60.8'
Set cedar post w/loc tag Due N 33'	13" Red Oak (clp 2) S25°W 30.9'
Ctr E-W dirt rd. Due N 3'	3" Red Oak N80°E 18.1'

* Found 1" pipe

SIGNED BY Carl F. Roser 01-24-86 DATE _____

SURVEYOR'S MICHIGAN REGISTRATION NO. 12028


FOR STATE AND UNITED STATES AGENCIES:

SIGNED BY _____ DATE _____

CHIEF OF SURVEY PARTY

APPROVED AND SIGNED BY _____ DATE _____

MICHIGAN REGISTERED LAND SURVEYOR

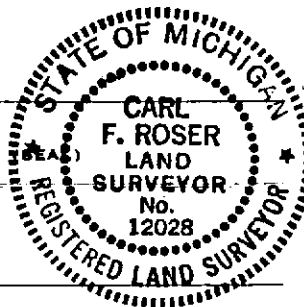

(SEAL)

SURVEYOR'S MICHIGAN REGISTRATION NO. _____

WEXFORD COUNTY