

RECEIVED

LAND CORNER RECORDATION CERTIFICATE
Filing Requirement of Act 74, Mich. P.A. 1970

1996 DEC 10 PM 4:03

For corners in

Form with fields for County (WEXFORD), Located In, Corner Code # (C-13), and numbered sections 1-5 for survey details.

Linda Loughmiller
WEXFORD COUNTY, MI
REGISTER OF DEEDS

SURVEY &
REMONUMENTATION

MAY 2 1997

Register of Deeds Stamp & File Number

I, CRAIG J. PULLEN, in a field survey on SEPTEMBER 26, 1996, do hereby state that under requirements of P.A. 74, Michigan P.A. of 1970, the corner points mentioned in lines 1 and 2 above were in conformance with regulations and rules therefore as required in the current manual of survey instructions of the United States Department of the Interior, Bureau of Land Management or by a decree of a Court of Law and/or that the corner points mentioned in lines 3, 4 and 5 above were in conformance with the rules of the Michigan Board of Land Surveyors or by a Decree of a Court of Law; established, re-established, monumented, recovered, found as expressed below:

NOTE: Not more than 2 corners, all in the same town and range, may be recorded on this certificate.

Grid table with columns A-L and rows 1-13, containing numerical values for survey points.

A. Description of original monument and accessories and/or subsequent restoration:

- List of survey descriptions including 1837 ORIGINAL GLO SURVEY BY J. BRINK, 1893 A.J. TEED SURVEY, 1906 D.E. TEED SURVEY, 1907 D.E. TEED SURVEY, 1916 C.A. HOFMEISTER'S PLAT OF KENWOOD PARK, 1939 PLAT OF SHADYSIDE PARK, 1947 PLAT OF MARATHON PARK, 1967 PLAT OF MAGGIE'S ACRES, 1972 J. SWITALSKI, 1972 M. MCCLUNG, 1977 GRANGER ENG. SURVEY, 1982 GRANGER ENG. SURVEY, 1986 GRANGER ENG SURVEYS, 1991 WADE-TRIM/GRANGER SURVEY, 1993 WADE-TRIM SURVEY, 1996 WADE-TRIM SURVEY.

B. Description of corner evidence found and/or method applied in restoring or reestablishing corner:


- C-13 FOUND 1/2" IRON IN MONUMENT BOX IN CENTERLINE OF DIVISION AND SENECA AND 5 PREVIOUS WITNESSES. REPLACED 1/2" IRON WITH 5/8" IRON AND BRASS CAP. THIS CORNER IS ACCEPTED AS THE BEST AVAILABLE EVIDENCE OF THE POSITION OF THE ORIGINAL CORNER.

C. Description of monument for corner and accessories established to perpetuate locating the position of the corner:

- C-13 SECTION CORNER COMMON TO SECTIONS 31 AND 32, T22N, R9W AND SECTIONS 5 AND 6, T21N, R9W
5/8" X 36" IRON AND BRASS CAP STAMPED: 31, 32, 5, 6, 1996, CJP, 39095
S29°W POWER POLE 51.61'
S41°E LIGHT POLE 45.31'
S59°W 18" TWIN RED PINE 38.92'
EAST WEST EDGE OF SANITARY MANHOLE RIM 7.2'

Signed by Craig J. Pullen

Surveyor's Michigan License No. 39095

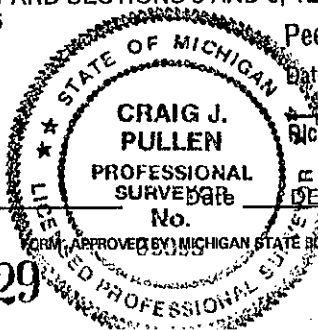

Peer Group Reviewed and Approved

Date: 10 Dec 96
Richard D. Wilcox, Wexford County Survey

DECEMBER 10, 1996