

RECEIVED

1996 DEC 10 PM 4:04

LAND CORNER RECORDATION CERTIFICATE
Filing Requirement of Act 74, Mich. P.A. 1970

For corners in

WEXFORD
(County)

Located In:

Corner Code #

- 1. Public Land Survey T 22N R 9W D-13
- T _____ R _____
- T _____ R _____
- T _____ R _____
- 2. Property Controlling S _____ T _____ R _____
- in Section S _____ T _____ R _____
- 3. Miscellaneous S _____ T _____ R _____
- Property in Sec. S _____ T _____ R _____
- 4. Lot No. _____, Recorded Plat _____
- 5. Private Claims _____


Linda Loughmiller
WEXFORD COUNTY, MI
REGISTER OF DEEDS

SURVEY &
RESPONSEMENT

MAY 29 1997

COMMISSION

Register of Deeds Stamp & File Number

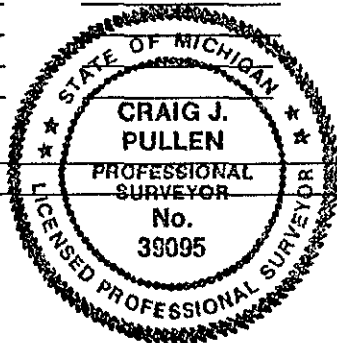

I, CRAIG J. PULLEN, in a field survey on SEPTEMBER 26, 19 96, do hereby state that under requirements of P.A. 74, Michigan P.A. of 1970, the corner points mentioned in lines 1 and 2 above were in conformance with regulations and rules therefor as required in the current manual of survey instructions of the United States Department of the Interior, Bureau of Land Management or by a decree of a Court of Law and/or that the corner points mentioned in lines 3, 4 and 5 above were in conformance with the rules of the Michigan Board of Land Surveyors or by a Decree of a Court of Law; established, re-established, monumented, recovered, found as expressed below:

NOTE: Not more than 2 corners, all in the same town and range, may be recorded on this certificate.

	A	B	C	D	E	F	G	H	I	J	K	L	M
1													
2		6		5		4		3		2		1	
3													
4		7		8		9		10		11		12	
5													
6		18		17		16		15		14		13	
7													
8		19		20		21		22		23		24	
9													
10		30		29		28		27		26		25	
11													
12		31		32		33		34		35		36	
13													

- A. Description of original monument and accessories and/or subsequent restoration:
- 1837 ORIGINAL GLO SURVEY BY J. BRINK WOOD POST YELLOW PINE 14 N41E 37 YELLOW PINE 16 N25W 45
 - 1893 A.J. TEED SURVEY IN SEC.5, T21N, R9W NO CORNER DESC. OR WITS GIVEN DISTANCE TO NW COR SEC.5 IS 2637.44'
 - 1898 D.E. TEED SURVEY IN SEC.32, T22N, R9W COMM AT IRON STAKE AT NW COR. OF C&M'S ADDITION = 1320' W OF SE COR SEC.32; THENCE PROJECTED LINE 1320½ FEET TO PT. 6' S OF ¼ POST. THIS ¼ POST IS OK, BUT IS FOUND ON ANGLE AT ¼ POST. MOVED THE ¼ POST 6' SOUTH OF GOV. PT. AND WIT. UP GOOD, OBLITERATED OLD CORNER W. PINE 20 S¼E 21 N. PINE 10 S15W 5.3' N. PINE 24 N20W 35¾
 - 1905 D.E. TEED SURVEY IN SEC.32, T22N, R9W NO CORNER DESCRIPTION W. PINE 18 S43W 43.8 FT.
 - 1915 & 1924 LAKEVIEW ADD & HIGHWAY PARK ADDITION TO THE CITY OF CADILLAC, SEC.5, T21N, R9W BY E.E. SOURS AND D.E. TEED, RESPECTIVELY DISTANCE TO E½ COR. ON N. SEC. LINE IS 1321.3'
 - 1947 D.E. TEED SURVEY IN SEC.32, T22N, R9W FOR MARATHON PARK PLAT IRON AT SURFACE ELEC. POLE N7°E 31.4 ELEC. POLE N51°E 45 NE COR HOUSE S56W 88.7
 - 1959 IVA R. HODGES PLAT, SEC.5, T21N, R9W BY N. SAGEMAN, PE #5156
 - 1968 CIRCLE VIEW PLAT, SEC.5, T21N, R9W BY R. HINKLEY, PS #13730
 - 1971 WILCOX & ERICKSON SURVEY IN SEC.32, T22N, R9W L.246, P.854 BY J.L. WILCOX, PS #14102 MON BOX
 - 1972 J. SWITALSKI, PS #13045, L.C.R.C., L.1, P.206 IRON RD IN MON BOX INT. DIVISION & LEESON
 - 1973 GRANGER ENG. SURVEY IN SEC.32, T22N, R9W, L.1, P.95 BY J. GRANGER, PS #16041 MON BOX
 - 1977 & 1986 GRANGER ENG. SURVEYS, L.1, P.518 & L.2, P.224 ½" IRON IN MON BOX P.POLE N46°E 45.94' P.POLE N74°E 138.18' F.HYD. S58°W 43.46'
 - 1980 WILCOX & ASSOC. SURVEY, L.1, P.843 ½" REROD IN MON BOX WITS SAME AS 1977 & 1986 GRANGER SURVEYS
 - 1991 WADE-TRIM/GRANGER SURVEY, L.71, P.505 IRON IN MON. BOX N60°E FIRE HYD 43.90' S20°E STOP SIGN 48.60' N50°E P.POLE 45.81' N20°W STOP SIGN 50.27'
 - 1993 WILCOX ASSOC SURVEY, L.72, P.385 ½" IRON IN MON BOX N50°E 45.87' P.POLE S58°W 43.89' TOP FIRE HYDR. S34°W 75.69' FENCE COR. N51°W 51.31' CTR. M.B.M.H.
 - 1993 WADE-TRIM SURVEY, L.75, P.358 IRON IN MON BOX N40°E P.POLE 45.8' S50°W 2" PIPE 46.30' S30°E STOP SIGN 48.45' N30°W STOP SIGN 50.1'

B. Description of corner evidence found and/or method applied in restoring or reestablishing corner:
D-13 FOUND ½" IRON IN MONUMENT BOX IN CENTERLINE OF WEST DIVISION AND LEESON STREETS AND 2 PREVIOUS WITNESSES. DISTANCE TO SW CORNER SECTION 32 IS 2638.36' (2638.44'-TEED) AND TO SE CORNER SECTION 32 IS 2642.44'. REPLACED ½" IRON WITH 5/8" X 36" IRON AND BRASS CAP. THIS CORNER IS ACCEPTED AS THE BEST AVAILABLE EVIDENCE OF THE POSITION OF THE ORIGINAL CORNER.

C. Description of monument for corner and accessories established to perpetuate locating the position of the corner:
D-13 ¼ CORNER COMMON TO SECTION 32, T22N, R9W AND SECTION 5, T21N, R9W
5/8" X 36" IRON AND BRASS CAP STAMPED: ¼, 32, 5, 1996, CJP, 39095
S58°W TOP CENTER FIRE HYDRANT 43.90'
N64°W 16" ASH 104.64'
N50°E POWER POLE 45.78'
S42°E NW CORNER HOUSE #1411 78.99'
S45°E NW EDGE OF RIM SANITARY MANHOLE 2.41'

Peer Group Reviewed and Approved
Date: 10 Dec 96
Richard D. Wilcox
Richard D. Wilcox, Wexford County Surveyor

Signed by Craig J. Pullen
Surveyor's Michigan License No. 39095

Date DECEMBER 10, 1996