

RECEIVED

1996 DEC 10 PM 4:04

LAND CORNER RECORDATION CERTIFICATE
Filing Requirement of Act 74, Mich. P.A. 1970

Linda Loughmiller
WEXFORD COUNTY, MI
REGISTER OF DEEDS

For corners in


WEXFORD (County) Located In: Corner Code #
1. Public Land Survey T. 22N R. 9W H-13
2. Property Controlling in Section S. T. R.
3. Miscellaneous Property in Sec. S. T. R.
4. Lot No. Recorded Plat
5. Private Claims

SURVEY &
RECORDATION

MAY 20 1997

COMMISSION

Register of Deeds Stamp & File Number

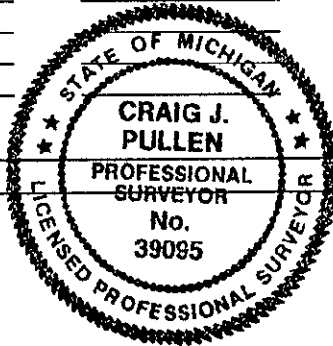

I, CRAIG J. PULLEN, in a field survey on OCTOBER 9, 1996, do hereby state that under requirements of P.A. 74, Michigan P.A. of 1970, the corner points mentioned in lines 1 and 2 above were in conformance with regulations and rules therefore as required in the current manual of survey instructions of the United States Department of the Interior, Bureau of Land Management or by a decree of a Court of Law and/or that the corner points mentioned in lines 3, 4 and 5 above were in conformance with the rules of the Michigan Board of Land Surveyors or by a Decree of a Court of Law; established, re-established, monumented, recovered, found as expressed below:

NOTE: Not more than 2 corners, all in the same town and range, may be recorded on this certificate.

Grid table with columns A-M and rows 1-13. Contains numerical data points for survey locations.

A. Description of original monument and accessories and/or subsequent restoration:

- 1837 ORIGINAL SURVEY BY J. BRINK WOOD POST WHITE PINE 14 N35 1/2 E 27 WHITE PINE 12 N52 1/2 W 23
1880 A.J. TEED SURVEY IN SEC.34, T22N, R9W BOTH WITNESSES
1882 J. CUMMER & SON'S ADDITION TO THE CITY OF CADILLAC BY A.J. TEED
1903 MILLER'S ADDITION AND WEBBER'S ADDITION TO THE CITY OF CADILLAC BY A.J. TEED
1905 HOME BUILDING & REALTY CO.'S ADDITION TO THE CITY OF CADILLAC BY A.J. TEED
1911 S.S. THORPE SUBDIVISION SEC.34, T22N, R9W BY ELSNER AND ARNOLD
1913 D.E. TEED SURVEY IN SEC.34, T22N, R9W USED STAKE IN MILLER'S ADDITION AND MEASURED 33' EAST
1966 M.S.H.D. L.C.R.C. L.2, P.850 BY C. ROSER, PS #12028 SET 4" OF ROUND IRON PIN IN BRICK AND BIT PAV'T. CORNER FITS TEED SURVEY DATA AND ADJACENT PLATS. NW COR BRICK CHURCH N30E 180.67 SE COR. BLOCK PORCH N25W 94.30' 15" MAPLE N55W 39.63' 16" MAPLE S70W 43.45' IRON PIPE DUE N. 33.0'
1973 J. GRANGER, PS #16041 L.C.R.C., L.1, P.419 4" IRON PIN IN BRICK & BIT PAV'T PLANS 1966 SAME WITS AS 1966.
1979 GRANGER ENG. SURVEY, L.1, P.752 BY J. RAY #25869 N35°E 27' P.P. S70°W 42' FIRE HYD. S53°E 33' C.G. PIPELINE MARKER
1989 WADE-TRIM/GRANGER SURVEY, L.68, P.429 BY J. RAY, PS #25869 MON BOX
1990 G. CARLSON, PS #24589, L.C.R.C., L.4, P.65 FOUND 1" BAR IN MONUMENT BOX 0.8' BELOW ROAD SURFACE IN CENTERLINE M-55 AND CARMEL ST. P.POLE N33E 50.38' 12" MAPLE S22°E 53.53' 11" ELM S32W 55.54' 12" MAPLE N67W 66.40'
1990 J. TAYLOR, PS #32342 L.C.R.C., L.4, P.45 FOUND 1 1/2" IRON BAR IN MON BOX IN INT. CARMEL ST. AND M-55. P.P. N45E 50.42' 10" BOX ELDER S40°E 53.58' 10" ELM S40°W 55.57' 10" NORWAY MAPLE N20°W 66.42'
1991 LEDY ENG. SURVEY IN L.70, P.546 BY D. LEDY, PS #21575 FOUND 1 1/2" ROD IN MON BOX WNW 66.43' 8" ASH NNE 30.43' POWER POLE NNW 94.30' SE COR. CONC. PORCH NE 121.12' TO SE COR. CHURCH
1995 WADE-TRIM SURVEY IN L.74, P.643 BY C. PULLEN, PS #39095 MON BOX CORNER FITS IRONS FOUND IN BLOCK 231 MILLER'S ADDITION TO THE CITY OF CADILLAC.

B. Description of corner evidence found and/or method applied in restoring or reestablishing corner:

H-13 FOUND 1" IRON IN MON. BOX 1' SOUTH OF CENTERLINE M-55 AND IN CENTERLINE CARMEL ST. AND 5 PREVIOUS WITNESSES. REPLACED IRON WITH 5/8" X 36" IRON AND BRASS CAP. DISTANCE TO SW CORNER SEC.34 IS 2624.45' (2621.0'-P) AND TO SE CORNER SEC.34 IS 2632.95' (2636.60'-P). THIS CORNER IS ACCEPTED AS THE BEST AVAILABLE EVIDENCE OF THE POSITION OF THE ORIGINAL CORNER.

C. Description of monument for corner and accessories established to perpetuate locating the position of the corner:

- H-13 1/4 CORNER COMMON TO SECTION 34, T22N, R9W AND SECTION 3, T21N, R9W
5/8" X 36" IRON AND BRASS CAP STAMPED: 1/4, 34, 3, 1996, CJP, 39095
N33°E POWER POLE 50.38'
S22°E 12" MAPLE 53.56'
S32°W 18" ELM 55.15'
N67°W 12" MAPLE 66.33'
N25°W SE CONCRETE BLOCK PORCH 94.30'

Peer Group Reviewed and Approved

Date: 10 Dec 96
Richard D. Wilcox, Wexford County Surveyor

Signed by Craig J. Pullen
Surveyor's Michigan License No. 39095

Date DECEMBER 10, 1996