

APR 16 1999

RECEIVED

1998 DEC 30 PM 2:11

SECTION

LAND CORNER RECORDATION CERTIFICATE
Filing Requirement of Act 74, Mich. P.A. 1970

Linda Loughmiller
WEXFORD COUNTY, MI
REGISTER OF DEEDS

For corners in

<u>Wexford</u> (County)	Located in:	Corner Code #
1. Public Land Survey	<u>T 22N R 09W</u>	<u>M-2</u>
	T _____ R _____	_____
	T _____ R _____	_____
	T _____ R _____	_____
2. Property Controlling in Section	S _____ T _____ R _____	_____
	S _____ T _____ R _____	_____
3. Miscellaneous Property in Sec.	S _____ T _____ R _____	_____
	S _____ T _____ R _____	_____

Register of Deeds Stamp & File Number

4. Lot No. _____, Recorded Plat _____
5. Private Claims _____

I, George D. Smith, P.S., in a field survey on April 16, 19 98 do hereby state that under requirements of P.A. 74, Michigan P.A. of 1970, the corner points mentioned in lines 1 and 2 above were in conformance with regulations and rules therefore as required in the current manual of survey instructions of the United States Department of the Interior, Bureau of Land Management or by a decree of a Court of Law and /or that the corner points mentioned in lines 3, 4 and 5 above were in conformance with the rules of the Michigan Board of Land Surveyors or by a Decree of a Court of Law; established, re-established, monumented, recovered, found as expressed below:

NOTE: Not more than 2 corners, all in the same town and range, may be recorded on this certificate.

1	A	B	C	D	E	F	G	H	I	J	K	L	M
2		6		5		4		3		2		1	
3													
4		7		8		9		10		11		12	
5													
6		18		17		16		15		14		13	
7													
8		19		20		21		22		23		24	
9													
10		30		29		28		27		26		25	
11													
12		31		32		33		34		35		36	
13													

A. Description of original monument and accessories and/or subsequent restoration:

- M-2) 1837 GLO Quarter Section Post by John Brink, Deputy Surveyor. Hemlock 10-S52½W-50; Yellow Pine 24-N67W-28
- M-2) 1883 A.J. Teed Survey, Liber 1, Page 120. Corner found no description given. White pine 14-S4½E-13; Distance to northeast corner measured 41.96 CHNS and distance to southeast corner measured 39.84 CHNS.
- M-2) 1959 K. Ostling, PS #10068, LCRC Liber 2, Page 954. Re-set corner by proportionate measurement between corners 1/2 mile to north and 1/2 mile to south. Set 1" pipe with 4" brass cap. 7" R. oak, N34E, 45 links, 8" R. oak, S43E, 32 links.
- M-2) 1979 J. Ray, PS #25869. Certificate of survey, Liber 1, Page 761 found DNR mon, N34°E 29.55' 8" R. oak, N14°W 14.90' 12" R. oak, S39°E 20.00' 12" R. oak. Distance to northeast corner measured 2790.24'.
- M-2) 1982 J. Ray, PS #25869. Certificate of Survey, Liber 1, Page 944. Found 1" pipe with 4" brass cap. Witnesses the same as 1959 K. Ostling, PS #10068 LCRC, distance to southeast corner measure 2624.25.
- M-2) 1982 J. Ray, PS #25869. Certificate of Survey, Liber 1, Page 946. Found 1" pipe with 4" brass cap. Witnesses the same as 1959 Ostling PS #10068 LCRC.
- M-2) 1995 Way PS# 28432 Cert. of Survey, Liber 75, Page 96. Corner found and used for parcel split, no witnesses or description of corner provided.


B. Description of corner evidence found and/or method applied in restoring or reestablishing corner:

Found DNR mon with brass cap. This corner is accepted as a careful and faithful re-establishment of the position of the original corner being the quarter corner common to Section 1 T22N-R9W and Section 6 T22N-R6W.

C. Description of monument for corner and accessories established to perpetuate locating the position of the corner:

- DNR mon with brass cap
- S55W 51.35' 16" White pine
- S35E 21.58' 12" Triple oak
- N40E 30.04' 8" Triple oak
- N10W 15.57' 14" Twin oak

Peer Group Reviewed and Approved
Date: 9 December 1998
Richard D. Wilcox
Richard D. Wilcox, Wexford County Surveyor

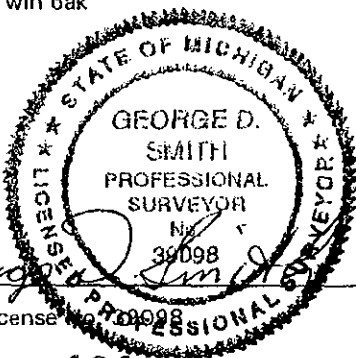

Signed by George D. Smith
Surveyor's Michigan License No. 39098

Date 12-9-98