

RECEIVED

1998 DEC 30 AM 10:18

Linda Lueghmiller  
WEXFORD COUNTY, MI  
REGISTER OF DEEDS

LAND CORNER RECORDATION CERTIFICATE  
Filing Requirement of Act 74, Mich. P.A. 1970

SECTION

For corners in

WEXFORD

(County)

Located In:

Corner Code #

1. Public Land Survey

T 22N R 12W

M-2

Common to:

2. Property Controlling  
in Section

S \_\_\_\_\_  
S \_\_\_\_\_

3. Miscellaneous  
Property in Sec.

S \_\_\_\_\_  
S \_\_\_\_\_

A-2 T22N, R11W  
(Wexford)

4. Lot No. \_\_\_\_\_, Recorded Plat \_\_\_\_\_

5. Private Claims \_\_\_\_\_

Register of Deeds Stamp & File Number

	A	B	C	D	E	F	G	H	I	J	K	L	M
1													
2		6		5		4		3		2		1	
3													
4		7		8		9		10		11		12	
5													
6		18		17		16		15		14		13	
7													
8		19		20		21		22		23		24	
9													
10		30		29		28		27		26		25	
11													
12		31		32		33		34		35		36	
13													

I, CRAIG J. PULLEN, PS, in a field survey on OCTOBER 15, 1998, do hereby state that under requirements of P.A. 74, Michigan P.A. of 1970, the corner points mentioned in lines 1 and 2 above were in conformance with regulations and rules therefore as required in the current manual of survey instructions of the United States Department of the Interior, Bureau of Land Management or by a decree of a Court of Law and/or that the corner points mentioned in lines 3, 4 and 5 above were in conformance with the rules of the Michigan Board of Land Surveyors or by a Decree of a Court of Law; established, re-established, monumented, recovered, found as expressed below:

NOTE: Not more than 2 corners, all in the same town and range, may be recorded on this certificate.

A. Description of original monument and accessories and/or subsequent restoration:

M-2 1838 G.L.O. SURVEY BY J. BRINK, WOOD POST, SUGAR 10 S65 1/2W 22 SUGAR 11 S51 1/2W 78  
1904 A.J. TEED SURVEY IN SECTION 1, T22N, R12W, FOUND 2 GOV. WITS., CORRECT GOV. WIT. SUGAR 10 S75 1/2°W 22, SUGAR 11 N50 1/2°W 76, NEW WIT. ELM 12 S14 1/4°W 27. DISTANCE TO SE CORNER OF SECTION 1 SHOWN AS 2643.96' AND DISTANCE NE CORNER OF SECTION SHOWN AS 2795.43'.  
1986 USFS SURVEY IN SECTION 1, T22N, R12W, BY R. MITCHELL PS #24617, LIBER 2, PAGE 192 AND L.C.R.C. LIBER 3, PAGE 388, ESTABLISHED BY RETRACEMENT OF A.J. TEED SURVEY OF 1904. SET STD. USFS 36" CONC. MONUMENT W/BRASS CAP, BY DOUBLE OVER OF LINE AND PRORATED DISTANCE TO GLO MEASUREMENT FROM CORNERS 1/4 AND 1/2 MILE TO THE NORTH. N78°E 20" MAPLE 15.62', S47°E 18" MAPLE 26.09', S22°W 14" MAPLE 15.38', S74°E 8" RED PINE 58.52'


B. Description of corner evidence found and/or method applied in restoring or reestablishing corner:

M-2 FOUND USFS CONCRETE MONUMENT AND BRASS CAP IN GOOD CONDITION 33' WEST OF TRAIL ROAD AND ALL 4 USFS WITNESSES. DISTANCE TO NE CORNER OF SECTION 1 IS 2770.89' (2795.43'-TEED)(2772'-G.L.O.) AND DISTANCE TO SE CORNER OF SECTION 1 IS 2638.23' (2643.96'-TEED). THIS CORNER IS ACCEPTED AS A CAREFUL AND FAITHFUL RE-ESTABLISHMENT OF THE POSITION OF THE ORIGINAL CORNER.

C. Description of monument for corner and accessories established to perpetuate locating the position of the corner:

M-2 1/4 CORNER COMMON TO SECTION 1, T22N, R12W & SECTION 6, T22N, R11W  
5" X 36" CONCRETE MONUMENT & BRASS CAP STAMPED: RLS, 1986, 28417, 1/4, T22N, R12W, 1, T22N, R11W, 6  
N70°E 22" MAPLE 15.62' (USFS)  
S47°E 20" MAPLE 26.11' (USFS)  
S22°W 16" MAPLE 15.34' (USFS)  
S74°E 10" RED PINE 58.52' (USFS)

Peer Group Reviewed and Approved  
Date: 11 Dec 98  
Richard D. Wilcox  
Richard D. Wilcox, Wexford County Surveyor

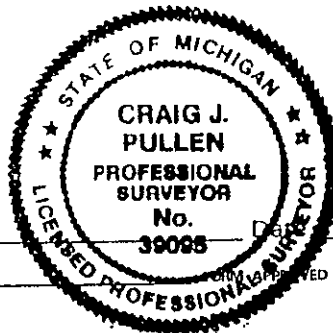

Signed by Craig J. Pullen

November 6, 1998

Surveyor's Michigan License No. 39095

LIBER 05 PAGE 100