

APR 16 1999

RECEIVED

1998 DEC 30 AM 10:18

LAND CORNER RECORDATION CERTIFICATE  
Filing Requirement of Act 74, Mich. P.A. 1970

*Linda Loughmiller*  
WEXFORD COUNTY, MI  
REGISTER OF DEEDS

SECTION

For corners in

WEXFORD  
(County)

Located In:

Corner Code #

1. Public Land Survey

T.22N R.12W

M-8

*Common to:*

- 2. Property Controlling in Section S
- 3. Miscellaneous Property in Sec. S

*A-8 T22N, R11W*

Register of Deeds Stamp & File Number

- 4. Lot No. \_\_\_\_\_, Recorded Plat \_\_\_\_\_
- 5. Private Claims \_\_\_\_\_

I, CRAIG J. PULLEN, PS, in a field survey on NOVEMBER 24, 1998, do hereby state that under requirements of P.A. 74, Michigan P.A. of 1970, the corner points mentioned in lines 1 and 2 above were in conformance with regulations and rules therefore as required in the current manual of survey instructions of the United States Department of the Interior, Bureau of Land Management or by a decree of a Court of Law and/or that the corner points mentioned in lines 3, 4 and 5 above were in conformance with the rules of the Michigan Board of Land Surveyors or by a Decree of a Court of Law; established, re-established, monumented, recovered, found as expressed below:

NOTE: Not more than 2 corners, all in the same town and range, may be recorded on this certificate.

	A	B	C	D	E	F	G	H	I	J	K	L	M
1													
2		6		5		4		3		2		1	
3													
4		7		8		9		10		11		12	
5													
6		18		17		16		15		14		13	
7													
8		19		20		21		22		23		24	
9													
10		30		29		28		27		26		25	
11													
12		31		32		33		34		35		36	
13													

A. Description of original monument and accessories and/or subsequent restoration:

M-8 1838 G.L.O. SURVEY BY J. BRINK, WOOD POST, BEECH 16 S23W 20, BEECH 10 N46W 75

B. Description of corner evidence found and/or method applied in restoring or reestablishing corner:


M-8 SET 5/8" X 36" IRON AND BRASS CAP BY SINGLE PROPORTIONATE MEASURE BETWEEN THE SE CORNER OF SECTION 36 AND THE NE CORNER OF SECTION 24, T22N, R12W. THE CORNER IS 9 FEET EAST OF THE CENTERLINE OF OLD NORTH-SOUTH ROAD GRADE. THIS CORNER IS ACCEPTED AS A CAREFUL AND FAITHFUL RE-ESTABLISHMENT OF THE POSITION OF THE ORIGINAL CORNER.

C. Description of monument for corner and accessories established to perpetuate locating the position of the corner:

M-8 1/4 CORNER COMMON TO SECTION 24, T22N, R12W & SECTION 19, T22N, R11W  
 5/8" X 36" IRON & BRASS CAP STAMPED: CJP, 39095, 1998, 1/4, 25, 30

N39°E	18" BEECH	26.65'
N71°E	8" CHERRY	17.11'
S43°W	7" BEECH	2.55'
N51°W	18" MAPLE	24.21'

Peer Group Reviewed and Approved  
 Date: Dec 9, 98  
*Richard D. Wilcox*  
 Richard D. Wilcox, Wexford County Surveyor

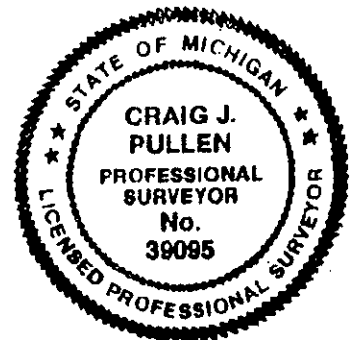

Signed by *Craig J. Pullen* Date December 3, 1998

Surveyor's Michigan License No. 39095